

MISSISSIPPI
BOARD OF WATER COMMISSIONERS FEB - 7 1972
416 North State Street
Jackson, Mississippi 39201

WATER WELL DRILLERS LOG

MISS. BD. OF
CODED
Pratt

Perry
B37
12-24-71

12-24 1971
date well completed

Robertson
firm name

county well located

LANDOWNER: *Maud Jean*
Reuther, Miss

description of formations encountered

from	to
0	18
18	23
23	42
42	52
52	70

(mailing address)

WELL LOCATION:

sec 25 T 5 N 10 E
S W
1 miles NW of Reuther
(distance) (direction) (nearest town)

WELL PURPOSE:

(home, irrigation, municipal, industrial)

WELL COMPLETION DATA:

- (1) diameter (inches) 4"
- (2) total depth (feet) 70
- (3) static water level (feet) 52 below above top of ground.
- (4) casing plastic 60
(material) (depth)
4 if telescope see back.
(size)
- (5) screen 10 60
(length) (depth to top)
4 plastic
(size) (material)
- (6) pump 3/4 600
(HP) (yield gpm)
Sub
(type power)
- (7) electric log _____
(yes or no)

CODED


(organization running log)

(8) how well bottom plugged None

DRILLERS REMARKS:

If well telescopes please sketch and show depths.

GROUND LEVEL

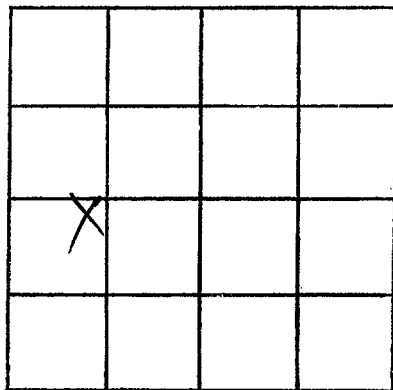

SECTION 25

Please indicate well location X.

ADDITIONAL INFORMATION

If more than one screen,
show locations of each on sketch.