

**PERRY**  
**B 42**  
**8-23-72**

MISSISSIPPI  
 BOARD OF WATER COMMISSIONERS  
 416 North State Street  
 Jackson, Mississippi 39201

**CODED**

WATER WELL DRILLERS LOG

Aug 23 1972 Proctor Drilling & Supply Perry  
 date well completed firm name county well located

LANDOWNER:	description of formations encountered	from	to
<u>Louis Hughes</u>			
<u>At 2 Buckton, Miss</u> (mailing address)	<u>clay</u>	<u>0</u>	<u>8</u>
	<u>sand</u>	<u>8</u>	<u>14</u>
	<u>sand + pea gravel</u>	<u>14</u>	<u>60</u>
	<u>still the sand</u>		
	<u>+ pea gravel</u>		
WELL LOCATION: sec. <u>1</u> T. <u>5</u> N. R. <u>10</u> E. <u>5</u> miles <u>N</u> of <u>Buckton</u> (distance) (direction) (nearest town)			
WELL PURPOSE: <u>drone</u> (home, irrigation, municipal, industrial)			
WELL COMPLETION DATA: (1) diameter (inches) <u>2'</u> (2) total depth (feet) <u>48</u> (3) static water level (feet) <u>23</u> <u>below</u> above top of ground. (4) casing <u>steel</u> , <u>43'</u> (material) (depth) <u>2"</u> (size) if telescope see back. (5) screen <u>5'</u> , <u>43'</u> (length) (depth to top) <u>2'</u> , <u>ball</u> , <u>S.S.</u> (size) (material) (6) pump <u>1/2</u> , <u>7</u> (HP) (yield gpm) <u>elec</u> (type power) (7) electric log <u>no</u> (yes or no) (organization running log) (8) how well bottom plugged <u>about 2/3</u>			
DRILLERS REMARKS:			

37' 1 1/2" long pipe


**CODED**

SEP 10 1972

MISS. Bd. of Water Comm.  
 Jackson, Miss.

If well telescopes please sketch and show depths.

GROUND LEVEL

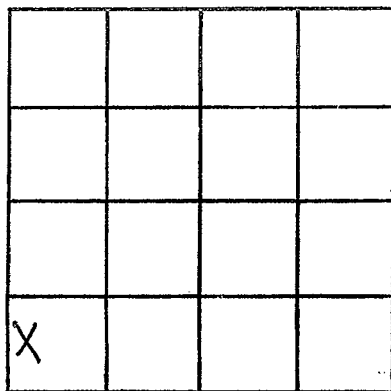

SECTION 1

Please indicate well location X.

ADDITIONAL INFORMATION

If more than one screen, show locations of each on sketch.