

MISSISSIPPI
BOARD OF WATER COMMISSIONERS
416 North State Street
Jackson, Mississippi 39201

CODED

WATER WELL DRILLERS LOG

PERRY
B 43
1-18-73

Jan 18 1973 Ray U Waste Water Wells Perry
date well completed firm name county well located

LANDOWNER: Gertrude Scribner
PO Box 277
Richston
(mailing address)

description of formations encountered	from	to
	Clay	0
Sandy Clay	0	45
Clay	45	100
Fine sand	100	127
Sandy Clay	127	138
Coarse sand	138	149

WELL LOCATION:
sec. 2 T. 5 N. R. 10 E
4 miles N of Richston
(distance) (direction) (nearest town)

WELL PURPOSE: Home
(home, irrigation, municipal, industrial)

- WELL COMPLETION DATA:
- (1) diameter (inches) 2 in
 - (2) total depth (feet) 149
 - (3) static water level (feet) 50 below above top of ground.
 - (4) casing galv 144
(material) (depth)
(size) if telescope see back.
 - (5) screen 5 144
(length) (depth to top)
2 in St Steel
(size) (material)
 - (6) pump 1 8
(HP) (yield gpm)
PEA
(type power)
 - (7) electric log NO
(yes or no)
 - (organization running log)
 - (8) how well bottom plugged Washed


JAN 24 1973
JAN 22 1973

MISS. DIV. OF
WATER CONTROL

DRILLERS REMARKS:

If well telescopes please sketch and show depths.

GROUND LEVEL

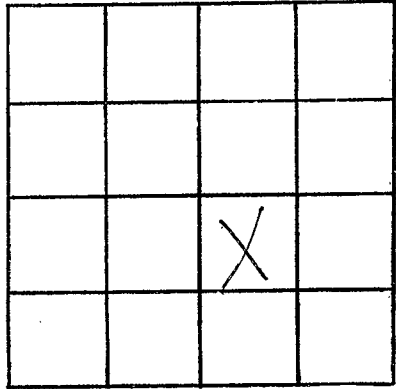

SECTION 2

Please indicate well location X.

ADDITIONAL INFORMATION

If more than one screen, show locations of each on sketch.