

Perry
B 45
9-20-79

MISSISSIPPI
BOARD OF WATER COMMISSIONERS
416 North State Street
Jackson, Mississippi 39201

This well
is on salt
dome -
shallow saline
water
CODED

WATER WELL DRILLERS LOG

4-20-1974 date well completed
74 Cochran Drilling firm name
Perry county well located

LANDOWNER:
Furman Hedgwood
Richton
(mailing address)

WELL LOCATION:
sec. 25 T 5 N R 10 E
3 miles NW of Richton
(distance) (direction) (nearest town)

WELL PURPOSE: irrigation
(home, irrigation, municipal, industrial)

WELL COMPLETION DATA:
(1) diameter (inches) 4"
(2) total depth (feet) 580
(3) static water level (feet) 60 below top of ground.
(4) casing PVC 550 (material) (depth)
(size) if telescope see back.
(5) screen 30 550 (length) (depth to top)
4" PVC (size) (material)
(6) pump 40 (HP) (yield gpm)
(type power)
(7) electric log no (yes or no)
(organization running log)
(8) how well bottom plugged none


description of formations encountered	from	to
tap soil	0	4
red clay	4	12
red sand	12	21
brown clay	21	34
gray clay	34	46
hard sand	46	65
blue clay	65	127
shale	127	199
blue clay	199	278
sand	278	320
blue clay	320	390
shale	390	416
blue clay	416	440
fine sand	440	460
blue clay	460	487
shale	487	499
blue clay	499	535
course sand	535	580

CODED
NOV 2 1974
MISS. BOARD OF WATER COMMISSIONERS

DRILLERS REMARKS:

If well telescopes please sketch and show depths.

GROUND LEVEL

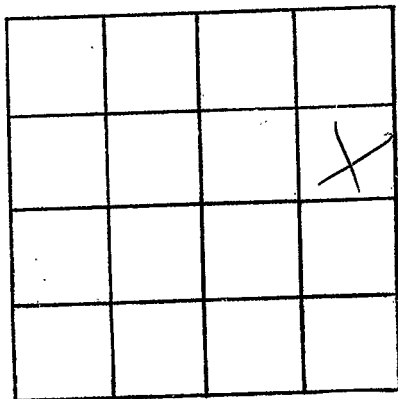

SECTION 25

Please indicate well location X.

ADDITIONAL INFORMATION

If more than one screen,
show locations of each on sketch.