

Perry  
B46  
11/4/73

MISSISSIPPI  
BOARD OF WATER COMMISSIONERS CODED  
416 North State Street  
Jackson, Mississippi 39201

WATER WELL DRILLERS LOG

11/4 date well completed 1973 Cochran Drilling Perry county well located

LANDOWNER:

Frank Hedgewood  
Richton Miss  
(mailing address)

description of formations encountered

from to

top soil	0	4
red clay	4	12
red sand	12	31
brown clay	21	34
gray clay	34	42
tan sand	42	65
blue clay	65	187
shale	187	199
blue clay	199	279
sand	279	320

WELL LOCATION:

sec. 25 T 5 S R 10 E  
3 miles NW of Richton  
(distance) (direction) (nearest town)

WELL PURPOSE: Irrigation  
(home, irrigation, municipal, industrial)

WELL COMPLETION DATA:

- (1) diameter (inches) 4"
- (2) total depth (feet) 320'
- (3) static water level (feet) 87' below top of ground.
- (4) casing PVC 290' (material) (depth)  
If telescope see back.  
(size)
- (5) screen 30' 290' (length) (depth to top)  
4" PVC (size) (material)
- (6) pump 2 sub 25 (HP) (yield gpm)  
Elec (type power)
- (7) electric log no (yes or no)  
(organization running log)
- (8) how well bottom plugged Valve


DRILLERS REMARKS:

NOV 28 1973

MISS. DE. OF WATER

If well telescopes please sketch and show depths.

GROUND LEVEL

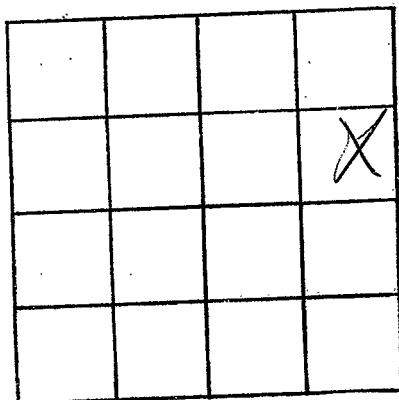

SECTION 25

Please indicate well location X.

ADDITIONAL INFORMATION

If more than one screen, show locations of each on sketch.