

C. P. CLARK
WATER WELL DRILLING

MISSISSIPPI
BOARD OF WATER COMMISSIONERS
416 North State Street
Jackson, Mississippi 39201


ROUTE 2
L, Miss. 39440
CODED

Perry
B 47
2-17-75

WATER WELL DRILLERS LOG

2/17 1975 C. P. Clark Perry
date well completed firm name county well located

LANDOWNER: <u>W.R. De Witt</u> <u>R.F.A. Rilton Miss</u>	description of formations encountered	from	to
(mailing address)	<u>Clay</u>	<u>0</u>	<u>114</u>
WELL LOCATION: sec. <u>15</u> T. <u>5</u> N. R. <u>10</u> E. <u>130</u> <u>4 1/2</u> miles <u>NW</u> of <u>Rilton</u> (distance) (direction) (nearest town)	<u>Sand streaks</u>	<u>114</u>	<u>120</u>
WELL PURPOSE: <u>House Water</u> (home, irrigation, municipal, industrial)	<u>Clay</u>	<u>120</u>	<u>275</u>
WELL COMPLETION DATA:	<u>Clay & thin sand streaks</u>	<u>275</u>	<u>312</u>
(1) diameter (inches) <u>2</u>	<u>Sandy clay</u>	<u>312</u>	<u>320</u>
(2) total depth (feet) <u>348</u>	<u>fine sand</u>	<u>320</u>	<u>348</u>
(3) static water level (feet) <u>120</u> below top of ground.	<u>Clay</u>	<u>348</u>	<u>360</u>
(4) casing <u>Galvanized</u> <u>324</u> (material) (depth)			
(size) if telescope see back.			
(5) screen <u>24</u> <u>324</u> (length) (depth to top)			
<u>1 1/4</u> <u>S.S. Gauge 80</u> (size) (material)			
(6) pump <u>2</u> <u>5</u> (HP) (yield gpm)			
<u>220V</u> <u>5 φ</u> (type power)			
(7) electric log <u>No</u> (yes or no)			
(organization running log)			
(8) how well bottom plugged <u>BWV</u>			
DRILLERS REMARKS: <u>Set 9 A Jet</u>			
<u>@ 147 ft Sta Rate Pump</u>			
<u>MW</u>			

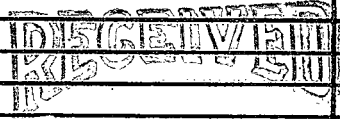


III - 7 1975

MISS. BD. OF WATER COMMISSIONERS

If well telescopes please sketch and show depths.

GROUND LEVEL

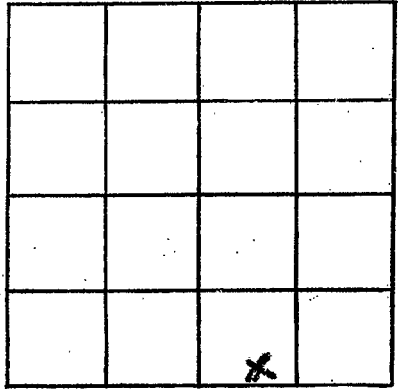

SECTION 15

Please indicate well location X.

ADDITIONAL INFORMATION

Lined area for additional information.

If more than one screen, show locations of each on sketch.