

C. P. CLARK  
WATER WELL DRILLING

MISSISSIPPI  
BOARD OF WATER COMMISSIONERS SEL. MISS. 39440  
416 North State Street  
Jackson, Mississippi 39201

CODED

WATER WELL DRILLERS LOG

PERRY  
B49  
3.23-76  
Elev. #122

3/23 1976 C.P. Clark Perry  
date well completed firm name county well located

LANDOWNER: <u>Frank H. Hegwood</u>	description of formations encountered	from	to
<u>Richton Miss</u>			
(mailing address)	<u>Red Sandy Clay</u>	<u>0</u>	<u>8</u>
WELL LOCATION:	<u>Sand</u>	<u>8</u>	<u>19</u>
sec. <u>26</u> T. <u>5</u> N. R. <u>10</u> E.	<u>Sand &amp; Gravel</u>	<u>19</u>	<u>58</u>
<u>1</u> miles <u>NW</u> of <u>Richton</u>	<u>Soft Clay</u>	<u>58</u>	<u>122</u>
(distance) (direction) (nearest town)	<u>Clay (Blue)</u>	<u>122</u>	<u>295</u>
WELL PURPOSE: <u>Domestic</u>	<u>Sand</u>	<u>295</u>	<u>325</u>
(home, irrigation, municipal, industrial)			
WELL COMPLETION DATA:			
(1) diameter (inches) <u>4</u>			
(2) total depth (feet) <u>325</u>			
(3) static water level (feet) <u>88</u> below above ground.			
(4) casing <u>Black Iron</u> <u>294</u>			
(material) (depth)			
<u>2 1/2</u> if telescope see back.			
(size)			
(5) screen <u>30</u> <u>295</u>			
(length) (depth to top)			
<u>2 1/2</u> <u>Solid SS. (Coak)</u>			
(size) (material)			
(6) pump <u>5</u> <u>75</u>			
(HP) (yield gpm)			
<u>230V 3φ Miss Power Co.</u>			
(type power)			
(7) electric log <u>Yes</u>			
(yes or no)			
<u>State Geo Survey</u>			
(organization running log)			
(8) how well bottom plugged <u>B.W.U</u>			
DRILLERS REMARKS: <u>Set pump @ 273ft on 2in wrap pipe</u>			

CODED


DRILLER'S SIGNATURE

MAR 29 1976

MISS. DE. OF WATER COMM

If well telescopes please sketch and show depths.

GROUND LEVEL

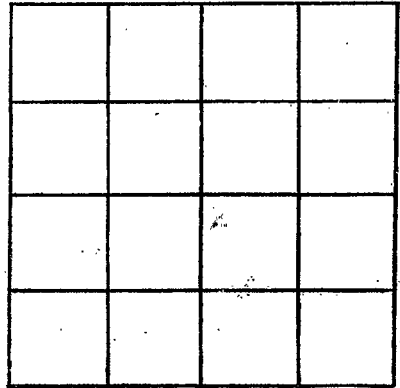

SECTION \_\_\_\_\_

Please indicate well location X.

ADDITIONAL INFORMATION

If more than one screen, show locations of each on sketch.