

C. P. CLARK

MISSISSIPPI WATER WELL DRILLING
BOARD OF WATER COMMISSIONERS ROUTE 2
416 North State Street LAUREL, MISS. 39440
Jackson, Mississippi 39201

CODED

WATER WELL DRILLERS LOG

Perry
B 50
11-8-77

11/8 1977 C.P. Clark Perry
date well completed firm name county well located

LANDOWNER:	Description of formations encountered	from	to
Mrs. Arthur M. Coulter			
Box 312	Surface Clay	0	15
Richton Miss 39416 (mailing address)	Sandy gravel	15	58
	Clay	58	329
WELL LOCATION: SW 1/4 - SW 1/4	fine sand	329	338
sec. 25 T. 5(N) R. 10E	Clay	338	344
1 miles NW of Richton	Sand (fine)	344	360
(distance) (direction) (nearest town)	Clay	360	390
WELL PURPOSE: Home			
(home, irrigation, municipal, industrial)			
WELL COMPLETION DATA:			
(1) diameter (inches) 2			
(2) total depth (feet) 360			
(3) static water level (feet) 88 below top of ground.			
(4) casing <u>Galv. Iron</u> 350 (material) (depth)			
10 If telescope see back. (size)			
(5) screen 10 350 (length) (depth to top)			
1/4 Solid S.S. (size) (material)			
(6) pump 2 5 1/2 (HP) (yield gpm)			
2200 (type power)			
(7) electric log NO (yes or no)			
(organization running log)			
(8) how well bottom plugged BWW			
DRILLERS REMARKS: Set 8 A jet @ 168'			


CODED

RECEIVED
NOV 17 1977

MISS. BD. OF WATER COMM.

If well telescopes please sketch and show depths.

GROUND LEVEL

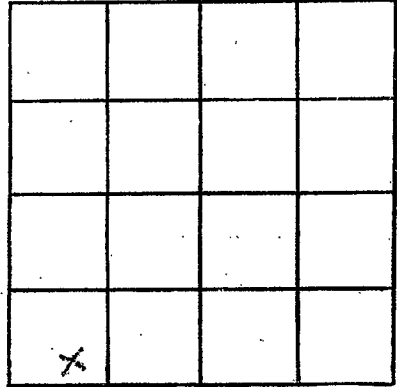

SECTION 25

Please indicate well location X.

ADDITIONAL INFORMATION

If more than one screen, show locations of each on sketch.