

Perry
B 51
3/31/78

C. P. CLARK
MISSISSIPPI WATER WELL DRILLING
BOARD OF WATER COMMISSIONERS ROUTE 2
416 North State Street LAUREL, MISS. 39440
Jackson, Mississippi 39201

WATER WELL DRILLERS LOG

CODED

3/31 1978 date well completed C.P. Clark firm name Perry county well located

LANDOWNER: Union Oil Co
Mobile Ala.

description of formations encountered	from	to
White Clay	0	17
Grey Clay	17	69
White Sand (fine)	69	72
Grey Clay	72	160
Shell & Sand streaks	160	190
Mud Clay	190	220
Brown Clay	220	259
Sand streaks Brown Clay	259	288
Clay (mud)	288	360
Sand	360	391
Clay CODED	391	410

(mailing address)

WELL LOCATION:

sec. 8 T. 5N R. 10E
5 1/2 miles NW of Puckett
(distance) (direction) (nearest town)

WELL PURPOSE: Ind
(home, irrigation, municipal, industrial)

WELL COMPLETION DATA:

- (1) diameter (inches) 4
- (2) total depth (feet) 391
- (3) static water level (feet) 30 below top of ground.
- (4) casing Galvalume 260 (material) (depth)
- (5) screen 31 260 (length) (depth to top)
2 1/2" Solid S.S. 006 (size) (material)
- (6) pump 5 100 @ 0 Psi (HP) (yield gpm)
230 V 1 φ (type power)
- (7) electric log no (yes or no)

(organization running log)

(8) how well bottom plugged Bwv

DRILLERS REMARKS:


Set pump @ 126 ft # 813 pump cable

RECEIVED
APR 10 1978

MISS. Bd. OF WATER COMMISSIONERS

If well telescopes please sketch and show depths.

GROUND LEVEL

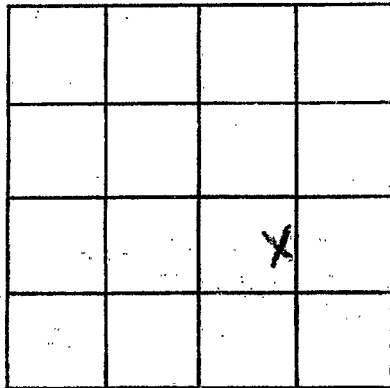

SECTION 8

Please indicate well location X.

ADDITIONAL INFORMATION

If more than one screen, show locations of each on sketch.