

Perry
B 52
9/15/78

MISSISSIPPI
BOARD OF WATER COMMISSIONERS CODED
416 North State Street
Jackson, Mississippi 39201

WATER WELL DRILLERS LOG


9-15 1978 Griner Drilling Service Perry
date well completed firm name county well located

LANDOWNER:	description of formations encountered	from	to
Union Oil of California Suite 325 Cottage Hill Rd Mobile, Ala. (mailing address)	streched Clay CODED	0 63	63 168
WELL LOCATION: sec. 9 T. 5 ^N R. 10 ^W Jones Co. - Perry Co. - line (distance) (direction) (nearest town)	streched with clay and sand Sand	168 357	357 399
WELL PURPOSE: oil field supply (home, irrigation, municipal, industrial)	sand 12' clay 2' sand	399	420
WELL COMPLETION DATA: (1) diameter (inches) 3" (2) total depth (feet) 420' (3) static water level (feet) 80' ^{below} / _{above} top of ground. (4) casing steel 420' (material) (depth) 3" (size) If telescope see back. (5) screen 42' (length) 378' (depth to top) 3" (size) perforated (material) (6) pump AC (HP) 65 (yield gpm) (type power) (7) electric log (yes or no) (organization running log) (8) how well bottom plugged orange peel	1350' S + 1525' E of NW cor.		
DRILLERS REMARKS:			

RECEIVED
OCT 30 1978
MISS. BD. OF WATER COMMISSIONERS

If well telescopes please sketch and show depths.

GROUND LEVEL

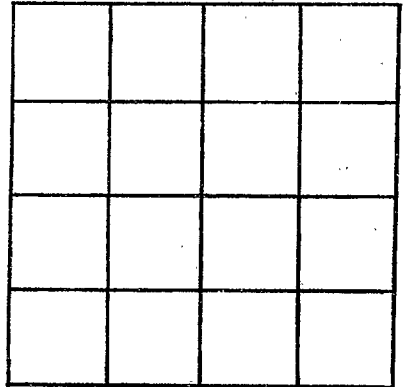

SECTION _____

Please indicate well location X.

ADDITIONAL INFORMATION

If more than one screen,
show locations of each on sketch.