

Perry
B77
6-25-81

MISSISSIPPI
BOARD OF WATER COMMISSIONERS
416 North State Street
Jackson, Mississippi 39201

CODED

WATER WELL DRILLERS LOG

6-25-81
date well completed

^{Clark}
C.P. Water Well Drilling
firm name

Perry
county well located

LANDOWNER: Carla Wilkerson

description of formations encountered

from to

pt 2

Richton, Miss
(mailing address)

WELL LOCATION:

sec. 16 T S N R. 10 E
S W
6 miles NW of Richton
(distance) (direction) (nearest town)

WELL PURPOSE: home
(home, irrigation, municipal, industrial)

WELL COMPLETION DATA:

- (1) diameter (inches) 2"
(2) total depth (feet) 158
(3) static water level (feet) 98 ^{below} above
top of ground.

(4) casing galv. 153
(material) (depth)

_____ if telescope see back.
(size)

(5) screen 5 153
(length) (depth to top)

2" Stainless Steel
(size) (material)

(6) pump 1 5 1/2
(HP) (yield gpm)

electric
(type power)

(7) electric log no
(yes or no)

_____ (organization running log)

(8) how well bottom plugged BWV


Top Soil	0	2
Red Sand Clay	2	34
Clay	34	97
Sand Clay	97	100
clay	100	110
Clay (Sand)	110	148
Sand Clay	148	160
Sand	160	161
Clay	161	163

DRILLERS REMARKS: f



If well telescopes please sketch and show depths.

GROUND LEVEL

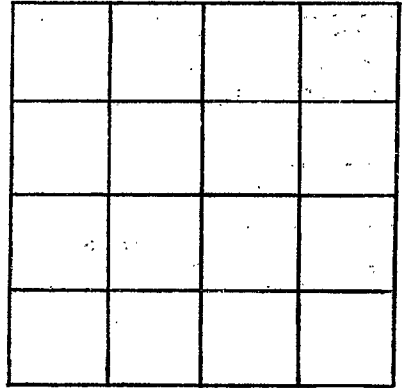

SECTION _____

Please indicate well location X.

ADDITIONAL INFORMATION

If more than one screen,
show locations of each on sketch.