

Perry
B 200

MISSISSIPPI
BOARD OF WATER COMMISSIONERS
416 North State Street
Jackson, Mississippi 39201

WATER WELL DRILLERS LOG

date well completed

19 *J.R. Green Water Well Dring.*
firm name

Perry
county well located

LANDOWNER: *J. H. Mc Laren*

Route 2

Righton, Mo 39476
(mailing address)

WELL LOCATION:

sec. *12* T. *5* N. R. *10* E
6 miles *N* of *Righton*
(distance) (direction) (nearest town)

WELL PURPOSE:

(home, irrigation, municipal, industrial)

WELL COMPLETION DATA:

- (1) diameter (inches) *1 1/2*
- (2) total depth (feet) *160*
- (3) static water level (feet) *48* below top of ground.
- (4) casing *PVC* *135*
(material) (depth)
If telescope see back.
(size)
- (5) screen *20'* *135'*
(length) (depth to top)
2 1/4 .008 *PVC*
(size) (material)
- (6) pump *1* *5*
(HP) (yield gpm)
220VAC
(type power)
- (7) electric log *NO*
(yes or no)

(organization running log)

(8) how well bottom plugged

DRILLERS REMARKS:

description of formations encountered


from to

<i>yellow</i>	<i>0</i>	<i>10</i>
<i>PINK</i>	<i>10</i>	<i>30</i>
<i>"</i>	<i>30</i>	<i>40</i>
<i>"</i>	<i>40</i>	<i>50</i>
<i>" Red Clay</i>	<i>50</i>	<i>60</i>
<i>Red Clay</i>	<i>60</i>	<i>70</i>
<i>" "</i>	<i>70</i>	<i>80</i>
<i>" "</i>	<i>80</i>	<i>90</i>
<i>" "</i>	<i>90</i>	<i>92</i>
<i>Rock</i>	<i>92</i>	
<i>Red Clay</i>		<i>100</i>
<i>" "</i>	<i>100</i>	<i>106</i>
<i>FINE SAND</i>	<i>106</i>	<i>110</i>
<i>" "</i>	<i>110</i>	<i>120</i>
<i>" "</i>	<i>120</i>	<i>130</i>
<i>" "</i>	<i>130</i>	<i>132</i>
<i>White Chalk</i>	<i>132</i>	<i>136</i>
<i>Med Sand</i>	<i>136</i>	<i>140</i>
<i>" "</i>	<i>140</i>	<i>150</i>
<i>" "</i>	<i>150</i>	<i>160</i>
<i>" "</i>	<i>160</i>	

1976

If well telescopes please sketch and show depths.

GROUND LEVEL

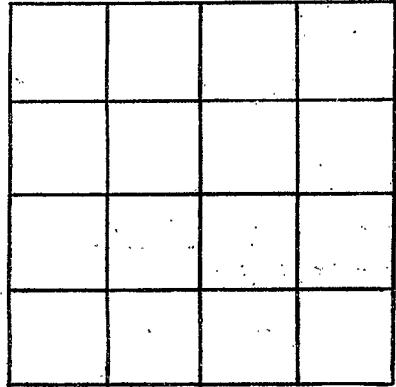

SECTION 12

Please indicate well location X.

ADDITIONAL INFORMATION

If more than one screen, show locations of each on sketch.