

Perry
B 2601
10-10-77

MISSISSIPPI WATER WELL DRILLING BOARD OF WATER COMMISSIONERS
416 North State Street, Jackson, Mississippi 39201
C. P. CLARK
ROUTE 2
LAUREL, MISS. 39440

WATER WELL DRILLERS LOG

Perry

10/10 1977 C.P. Clark
date well completed firm name county well located

LANDOWNER: *Caro Mullford*
Pt # 2
Richton Miss
(mailing address)

description of formations encountered	from	to
<i>Sandy Clay</i>	<i>0</i>	<i>32</i>
<i>White Clays</i>	<i>32</i>	<i>79</i>
<i>Sand &</i>	<i>79</i>	<i>85</i>

WELL LOCATION:
sec. *16* T. *5* (N) R. *10* (E)
6 miles *NW* of *Richton*
(distance) (direction) (nearest town)

WELL PURPOSE: *Home*
(home, irrigation, municipal, industrial)

- WELL COMPLETION DATA:
- (1) diameter (inches) 2
 - (2) total depth (feet) 85
 - (3) static water level (feet) 72 below top of ground.
 - (4) casing Galvachon 80
(material) (depth)
 - (size) if telescope see back.
 - (5) screen 5 80
(length) (depth to top)
 - 2 in Solid S.S. 006
(size) (material)
 - (6) pump 1 7 1/2
(HP) (yield gpm)
 - 2400 1 φ
(type power)
 - (7) electric log No
(yes or no)
 - (organization running log)
 - (8) how well bottom plugged BWV


DRILLERS REMARKS: *Set 12A*
Set @ 78 ft New
Sta Rita Jet Pump

RECEIVED
OCT 16 1977

MISS. BD. OF WATER COMMISSIONERS

If well telescopes please
sketch and show depths.

GROUND LEVEL

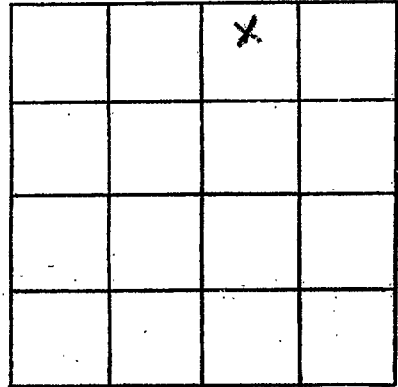

SECTION 16

Please indicate well location X.

ADDITIONAL INFORMATION

If more than one screen,
show locations of each on sketch.