

C. P. CLARK

MISSISSIPPI WATER WELL DRILLING
BOARD OF WATER COMMISSIONERS ROUTE 2
416 North State Street LAUREL, MISS. 39440
13¢ Jackson, Mississippi 39201

Perry
B 2802
7/21/77

WATER WELL DRILLERS LOG

7/21 1977 C.P. Clark Perry
date well completed firm name county well located

LANDOWNER: Joel Howell
Ridgton, Miss

description of formations encountered

from to

Clay 0 69
Sand 69 74
Clay 74 90
Sand 90 110

(mailing address)

WELL LOCATION:

sec. 35 T 5N R 10E
S
1 miles West of Ridgton
(distance) (direction) (nearest town)

WELL PURPOSE: Home
(home, irrigation, municipal, industrial)

WELL COMPLETION DATA:

- (1) diameter (inches) 2
- (2) total depth (feet) 110
- (3) static water level (feet) 50 below top of ground.
- (4) casing Galvalume 105 (material) (depth)
- (size) If telescope see back.
- (5) screen 5 105 (length) (depth to top)
1 1/4 Solid SS, 006 (size) (material)
- (6) pump 1 10 (HP) (yield gpm)
2200 (type power)
- (7) electric log No (yes or no)

(organization running log)

(8) how well bottom plugged BwU


DRILLERS REMARKS: Set 12 A
jet @ 84 ft

RECEIVED
AUG 26 1977

MISS. BD. OF WATER COMMISSIONERS

If well telescopes please sketch and show depths.

GROUND LEVEL

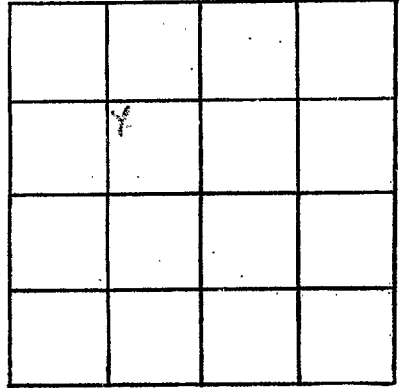

SECTION 35

Please indicate well location X.

ADDITIONAL INFORMATION

A series of horizontal lines providing space for additional information.

If more than one screen, show locations of each on sketch.