

PERRY
 B 2003
 6-23-79

MISSISSIPPI
 BOARD OF WATER COMMISSIONERS
 416 North State Street
 Jackson, Mississippi 39201

WATER WELL DRILLERS LOG

6-23-79 date well completed
 Roy West water wells Perry firm name
 county well located

LANDOWNER: Ethridge Edward
 Rf 2
 Reekton Box 39
 (mailing address)

description of formations encountered		from	to
sandy clay		0	15
sand		15	87

WELL LOCATION:
 sec. 13 T 8 N R 10 E
 S 4 miles N of Reekton Miss
 (distance) (direction) (nearest town)

WELL PURPOSE: home
 (home, irrigation, municipal, industrial)

- WELL COMPLETION DATA:
- (1) diameter (inches) 2
 - (2) total depth (feet) 80
 - (3) static water level (feet) 40 below above top of ground.
 - (4) casing PVC 75 (material) (depth)
 - (size) If telescope see back.
 - (5) screen 5 75 (length) (depth to top)
 - 1/4" steel (size) (material)
 - (6) pump 1 5 (HP) (yield gpm)
 - R.E.A. (type power)
 - (7) electric log NO (yes or no)
 - (organization running log)
 - (8) how well bottom plugged wash water JUL 16 1979


DRILLERS REMARKS:

Miss. Board of Water Commis

RECEIVED

If well telescopes please sketch and show depths.

GROUND LEVEL

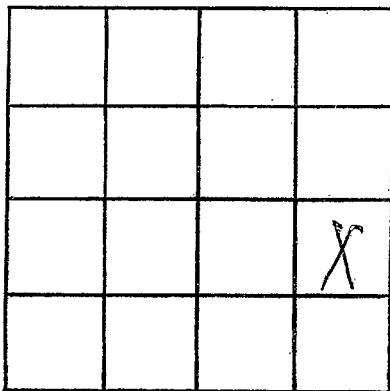

SECTION

13

Please indicate well location X.

ADDITIONAL INFORMATION

If more than one screen,
show locations of each on sketch.