

Perry
B 2004
9-23-80

MISSISSIPPI DEPARTMENT OF NATURAL RESOURCES

Bureau of Land and Water Resources

Southport Mall

P.O. Box 10631

Jackson, Mississippi 39209

WATER WELL DRILLERS LOG

Sept. 23 1980 COCHRAN BROTHER DRILLING SERVICE PERRY
date well completed firm name county well located

LANDOWNER:	description of formations encountered	from	to
<u>B.C. CLARK</u>			
<u>RT 3 BOX 150</u> <u>Richton, Miss</u> (mailing address)	<u>TOP SOIL</u>	<u>5</u>	<u>2</u>
	<u>RED CLAY</u>	<u>2</u>	<u>10</u>
	<u>RED SAND</u>	<u>10</u>	<u>14</u>
	<u>BROWN SAND</u>	<u>14</u>	<u>19</u>
	<u>FINE SAND</u>	<u>19</u>	<u>36</u>
	<u>GRAY SAND</u>	<u>36</u>	<u>62</u>
	<u>BLUE SAND</u>	<u>62</u>	<u>91</u>
	<u>BLUE SHALE</u>	<u>91</u>	<u>140</u>
	<u>GRAY CLAY</u>	<u>140</u>	<u>154</u>
	<u>BLUE CLAY</u>	<u>154</u>	<u>169</u>
	<u>SAND</u>	<u>169</u>	<u>190</u>

WELL LOCATION:
sec. 17 T. 5 N. R. 10 E. W.
6 miles N.W. of Richton
(distance) (direction) (nearest town)

WELL PURPOSE: Home
(home) irrigation, municipal, industrial

- WELL COMPLETION DATA:
- (1) diameter (inches) 2"
 - (2) total depth (feet) 190'
 - (3) static water level (feet) 63 below above top of ground.
 - (4) casing PVC, 180' (material) (depth)
 - (5) screen 10', 180' (length) (depth to top)
2", PVC (size) (material)
 - (6) pump 1, 8 (HP) (yield gpm)
Electric (type power)
 - (7) electric log NO (yes or no)
(organization running log)
 - (8) how well bottom plugged VALUE


DRILLERS REMARKS:

DEPT. OF NATURAL RESOURCES
BUREAU OF LAND & WATER RESOURCES

NOV - 3 1980
RECEIVED

If well telescopes please sketch and show depths.

GROUND LEVEL

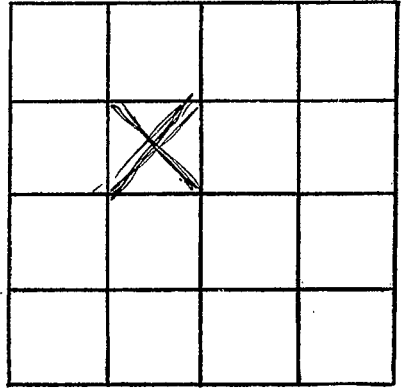

SECTION 17

Please indicate well location X.

ADDITIONAL INFORMATION

Lined area for additional information.

If more than one screen, show locations of each on sketch.