

PERRY

B 2005

10-10-80

MISSISSIPPI
BOARD OF WATER COMMISSIONERS
416 North State Street
Jackson, Mississippi 39201

WATER WELL DRILLERS LOG

June 6 date well completed Roy V West Drilling firm name Perry county well located

LANDOWNER: Thomas Hollingsworth
Oueh MS description of formations encountered: SAND from 0 to 14

(mailing address)

WELL LOCATION:

sec. 6 T 5 N R 10 E
S W
20 miles NE of Runnels town
(distance) (direction) (nearest town)

WELL PURPOSE: ~~Water~~
(home, irrigation, municipal, industrial)

WELL COMPLETION DATA:

(1) diameter (inches) 4
(2) total depth (feet) 14
(3) static water level (feet) 5 below above top of ground.

(4) casing PVC, 5
(material) (depth)

(size) If telescope see back.

(5) screen 9' 3'
(length) (depth to top)

2" PVC
(size) (material)

(6) pump 10
(HP) (yield gpm)

REA
(type power)

(7) electric log NO
(yes or no)

(organization running log)

(8) how well bottom plugged
WASH VALVE

DRILLERS REMARKS:


DEPT. OF NATURAL RESOURCES
BUREAU OF LAND & WATER RESOURCES

JUL 16 1980

RECEIVED

If well telescopes please sketch and show depths.

GROUND LEVEL

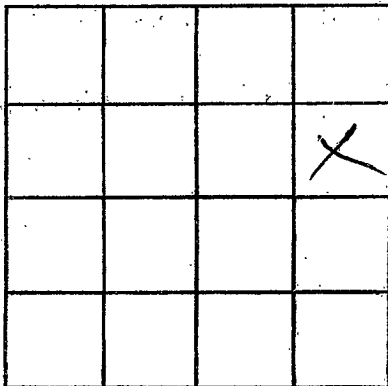

SECTION _____

Please indicate well location X.

ADDITIONAL INFORMATION

If more than one screen, show locations of each on sketch.