

MISSISSIPPI DEPARTMENT OF NATURAL RESOURCES
Bureau of Land and Water Resources
 Southport Mall
 P.O. Box 10631
 Jackson, Mississippi 39209
WATER WELL DRILLERS LOG

<i>Perry</i>
<i>B 2006</i>
<i>9-24-81</i>

9-24-81 date well completed *Cochran Brothers Drilling* firm name *Perry* county well located

LANDOWNER:
Charles Clark
Rt 1 Richton
 (mailing address)

description of formations encountered	from	to
<i>Top soil</i>	<i>0</i>	<i>2</i>
<i>Red clay</i>	<i>2</i>	<i>8</i>
<i>Red sand</i>	<i>8</i>	<i>12</i>
<i>Gray clay</i>	<i>12</i>	<i>18</i>
<i>sand</i>	<i>18</i>	<i>35</i>

WELL LOCATION:
 sec. *17* T. *5* N S R. *10* E W
7 miles *NW* of *Richton*
 (distance) (direction) (nearest town)

WELL PURPOSE: *None*
 (~~Home~~) Irrigation, municipal, industrial)


- WELL COMPLETION DATA:**
- (1) diameter (inches) *2"*
 - (2) total depth (feet) *35'*
 - (3) static water level (feet) *18* ^{below} top of ground.
 - (4) casing *PVC*, *30'*
 (material) (depth)
 (size) if telescope see back.
 - (5) screen *5' 30'*
 (length) (depth to top)
2", *PVC*
 (size) (material)
 - (6) pump *1* *7*
 (HP) (yield gpm)
Elc
 (type power)
 - (7) electric log *no*
 (yes or no)
 - (organization running log)
 - (8) how well bottom plugged *value*

DRILLERS REMARKS:

DEPT. OF NATURAL RESOURCES
 BUREAU OF LAND & WATER RESOURCES
 OCT 10 1981
RECEIVED

If well telescopes please
sketch and show depths.

GROUND LEVEL

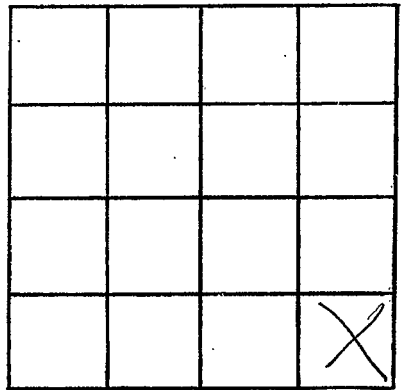

SECTION 12

Please indicate well location X.

ADDITIONAL INFORMATION

If more than one screen,
show locations of each on sketch.