

MISSISSIPPI DEPARTMENT OF NATURAL RESOURCES

Bureau of Land and Water Resources

Southport Mall

P.O. Box 10631

Jackson, Mississippi 39209

WATER WELL DRILLERS LOG

Perry
2004 B

July 21-1982 date well completed *Cochran Bore Drilling* firm name *PERRY* county well located

LANDOWNER:	description of formations encountered	from	to
<i>Wendell Tisdale</i>			
<i>Pt. 2 Richton</i> (mailing address)	<i>GRAY clay</i>	<i>1</i>	<i>15</i>
	<i>Sand</i>	<i>15</i>	<i>25</i>

WELL LOCATION:
 sec. *15* T *5* *N* R. *10* *E*
6 miles *W* of *Good Hope*
 (distance) (direction) (nearest town)

WELL PURPOSE: *Home*
 (home, irrigation, municipal, industrial)

- WELL COMPLETION DATA:
- (1) diameter (inches) *2"*
 - (2) total depth (feet) *25'*
 - (3) static water level (feet) *16* ^{below} above top of ground.
 - (4) casing *PVC*, *20'*
 (material) (depth)
 (size) If telescope see back.
 - (5) screen *5'*, *20'*
 (length) (depth to top)
2", *PVC*
 (size) (material)
 - (6) pump *1*, *6*
 (HP) (yield gpm)
elec
 (type power)
 - (7) electric log *no*
 (yes or no)
 (organization running log)
 - (8) how well bottom plugged *value*

DRILLERS REMARKS:


DEPT. OF NATURAL RESOURCES
 BUREAU OF LAND & WATER RESOURCES

OCT - 4 1982

RECEIVED

If well telescopes please sketch and show depths.

GROUND LEVEL

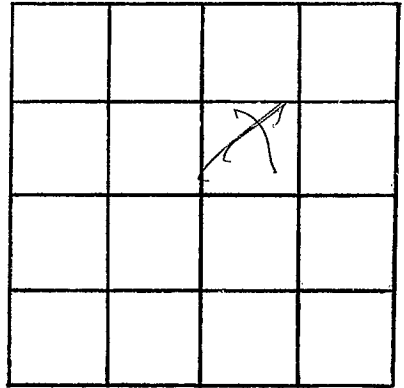

SECTION 15

Please indicate well location X.

ADDITIONAL INFORMATION

If more than one screen,
show locations of each on sketch.