

MISSISSIPPI DEPARTMENT OF NATURAL RESOURCES

Bureau of Land and Water Resources

Southport Mall

P.O. Box 10631

Jackson, Mississippi 39209

WATER WELL DRILLERS LOG

Jerry B
2008

June 23 1990 @ Cochran Bros Drilling PERKY
date well completed firm name county well located

LANDOWNER: <u>Rubben Odum</u> <u>PO Box 1 Richton</u> (mailing address)	description of formations encountered	from	to
WELL LOCATION: Sec. <u>25</u> T. <u>5</u> N. R. <u>10</u> E. S. <u>3</u> miles <u>NW</u> of <u>Richton</u> (distance) (direction) (nearest town)	TOP Soil	0	2
	Red clay	2	5
	Red sand	5	9
	DRAY clay	9	15
	sand	15	55
	Blue clay	55	120
	sand	120	124
	Blue clay	124	220
	sand	220	240

WELL PURPOSE: None
(home, irrigation, municipal, industrial)

WELL COMPLETION DATA:

- (1) diameter (inches) 2 1/2
- (2) total depth (feet) 240
- (3) static water level (feet) 38 below above top of ground.
- (4) casing PVC, 230'
(material) (depth)
- (size) If telescope see back.
- (5) screen 10', 230'
" (length) (depth to top)
- (size) (material)
- (6) pump 1, 5
(HP) (yield gpm)
- (type power) Elec
- (7) electric log no
(yes or no)
- (organization running log)
- (8) how well bottom plugged water

DRILLERS REMARKS:


DEPT. OF NATURAL RESOURCES
BUREAU OF LAND & WATER RESOURCES

OCT - 4 1990

RECEIVED

If well telescopes please sketch and show depths.

GROUND LEVEL

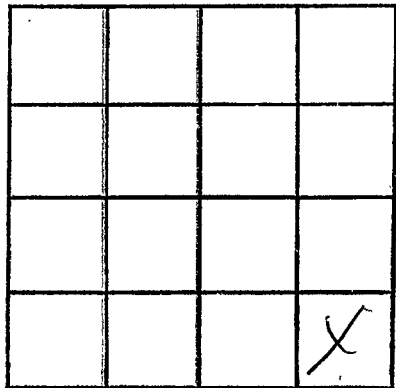

SECTION

25

Please indicate well location X.

ADDITIONAL INFORMATION

If more than one screen, show locations of each on sketch.