

**MISSISSIPPI DEPARTMENT OF NATURAL RESOURCES**  
**Bureau of Land and Water Resources**  
 Southport Mall  
 P.O. Box 10631  
 Jackson, Mississippi 39209  
**WATER WELL DRILLERS LOG**

Derry  
B 2009

Jan 4-82 date well completed      Cochran Bro. Drilling Service firm name      PERE county well located

LANDOWNER:	description of formations encountered	from	to
<u>Sam GARRIS</u> <u>Rt 2 Richton</u> (mailing address)	<u>Top soil</u>	<u>0</u>	<u>1</u>
<b>WELL LOCATION:</b> sec. <u>2</u> T. <u>5</u> N. R. <u>10</u> E S W <u>1/2</u> miles <u>5</u> of <u>Rhodes</u> (distance) (direction) (nearest town)	<u>GRAY CLAY</u>	<u>1</u>	<u>5</u>
<b>WELL PURPOSE:</b> (home, irrigation, municipal, industrial)	<u>Sand Blue clay</u>	<u>5</u>	<u>90</u>
<b>WELL COMPLETION DATA:</b>	<del>Blue sand</del> <u>Blue clay</u>	<u>90</u>	<u>93</u>
(1) diameter (inches) <u>2"</u>	<u>Blue clay</u>	<u>93</u>	<u>310</u>
(2) total depth (feet) <u>450'</u>	<u>Blue clay shale</u>	<u>310</u>	<u>320</u>
(3) static water level (feet) <u>42</u> <sup>below</sup> above top of ground.	<del>Blue clay</del> <u>Sand</u>	<u>410</u>	<u>450</u>
(4) casing <u>PVC</u> <u>440'</u> (material) (depth)			
_____ if telescope see back. (size)			
(5) screen <u>10'</u> <u>440'</u> (length) (depth to top)			
<u>2"</u> <u>PVC</u> (size) (material)			
(6) pump <u>1</u> <u>5</u> (HP) (yield gpm)			
<u>Elec</u> (type power)			
(7) electric log <u>no</u> (yes or no)			
_____ (organization running log)			
(8) how well bottom plugged <u>valve</u>			

**DRILLERS REMARKS:**  
 \_\_\_\_\_  
 \_\_\_\_\_  
 \_\_\_\_\_


DEPT. OF NATURAL RESOURCES  
 BUREAU OF LAND & WATER RESOURCES

NOV 17 1982

**RECEIVED**

If well telescopes please sketch and show depths.

GROUND LEVEL

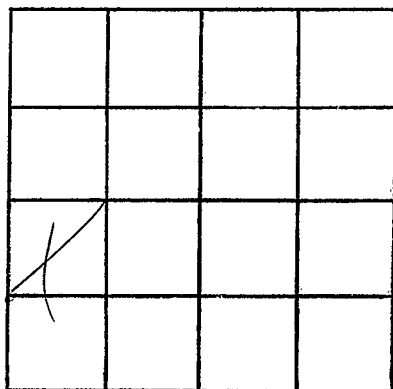

SECTION 2

Please indicate well location X.

ADDITIONAL INFORMATION

If more than one screen,  
show locations of each on sketch.