

# MISSISSIPPI DEPARTMENT OF NATURAL RESOURCES

Bureau of Land and Water Resources

P.O. Box 10631  
Jackson, Mississippi 39209  
WATER WELL DRILLERS LOG

COUNTY WELL LOCATED <i>Perry</i>	
WELL NUMBER <i>B</i>	CODED
DATE WELL COMPLETED <i>2011 July 23-1987</i>	

PERMIT NUMBER
NAME OF DRILLING FIRM <i>Cochran Water Well Services</i>

NAME & MAILING ADDRESS OF LANDOWNER <i>Mark Clark Rt 1 Richton</i>			
WELL LOCATION: SEC	TOWNSHIP	RANGE	
<i>17</i>	<i>5</i>	<i>10</i>	
DISTANCE <i>6</i> Miles	DIRECTION <i>W</i>	NEAREST TOWN <i>Richton</i>	
OTHER LANDMARK			
WELL PURPOSE <i>H</i> Home, Irrigation, Municipal, Industrial, Fish Pond, etc.			

PUMP DATA		
PUMP TYPE (Circle One): Submersible, Turbine, <input checked="" type="radio"/> Jet, Flowing Well, Other (Describe) _____		
POWER TYPE (Circle One): <input checked="" type="radio"/> Electric, Tractor, Diesel, Gasoline, Butane, Other (Describe) _____		
Pump Capacity (GPM) <i>6</i>	No. of Stages <i>2</i>	Setting Depth <i>80</i> FT.
PUMP TEST Well yielded <i>6</i> GPM with a drawdown of _____ ft. after _____ hours of pumping		

WELL DATA		
Well Depth <i>560'</i>	Casing Diameter (In.) <i>2</i>	Casing Length (Ft.) <i>550</i>
Type of Casing <i>PVC</i>	Hole Depth <i>560'</i>	Depth to Static Water Level <i>65'</i>
TYPE OF COMPLETION: (Circle One or More): <input checked="" type="checkbox"/> Gravel Packed, <input type="checkbox"/> Underreamed, <input type="checkbox"/> Telescoped, <input checked="" type="checkbox"/> Natural Development, <input type="checkbox"/> Open Hole, <input type="checkbox"/> Other (Describe) _____		
Top of Lap Pipe or Reduction in Casing  FEET <input type="checkbox"/> IF TELESCOPED OR MORE THAN ONE SCREEN: USE BACK PAGE		

LOG DATA	
TYPE OF LOG RUN (Circle One): Electric, Gamma Ray, Density, Sonic, <input checked="" type="radio"/> No Log Run, Neutron, Other (Describe) _____	
Name of Organization Running Log	

SCREEN DATA		
Diameter - Inches <i>2</i>	Length - Feet <i>10</i>	Slot Size - Inches <i>8</i>
Screen Type <i>PVC</i>	Depth to Bottom - Feet <i>560</i>	

GEOLOGIC DATA (Office Use Only)			
Surface Elev.	Geologic Unit	Unit Thickness	Depth to Top
Subs. SWL	Date	Analysis	Aquifer Test
Driller's Remarks			

DESCRIPTION OF FORMATIONS ENCOUNTERED	FROM	TO	FORMATIONS (Continued)	FROM	TO
<i>TOP SOIL</i>	<i>0</i>	<i>1</i>	<div style="font-size: 2em; font-weight: bold; opacity: 0.5;">RECEIVED</div> <div style="font-size: 1.5em; font-weight: bold; margin-top: 10px;">OCT 27 1987</div> <div style="font-size: 0.8em; font-weight: bold; margin-top: 10px;">Department of Natural Resources Bureau of Land &amp; Water Resources</div>		
<i>Red clay</i>	<i>1</i>	<i>4</i>			
<i>gray clay</i>	<i>4</i>	<i>18</i>			
<i>Blue clay</i>	<i>18</i>	<i>321</i>			
<i>Sand</i>	<i>321</i>	<i>324</i>			
<i>Blue clay</i>	<i>324</i>	<i>510</i>			
<i>Sand</i>	<i>510</i>	<i>560</i>			


IF MORE SPACE IS NEEDED, USE BACK

If well telescopes please  
sketch and show depths.

---

GROUND LEVEL

---

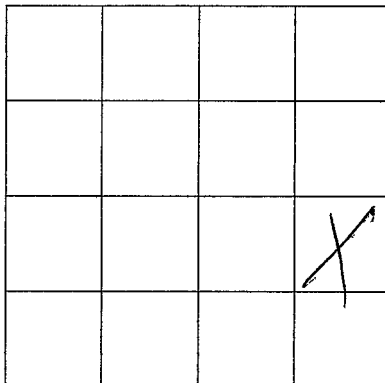

SECTION 17

Please indicate well location X.

---

**ADDITIONAL INFORMATION**

---

If more than one screen,  
show location of each on sketch.

---