

C. P. CLARK  
WATER WELL DRILLING

MISSISSIPPI  
BOARD OF WATER COMMISSIONERS, MISS. 39440

ROUTE 2  
416 North State Street

Jackson, Mississippi 39201

WATER WELL DRILLERS LOG

Perry  
B 2015  
10/26/76

13¢

Perry

10/26/1976  
date well completed

firm name

county well located

LANDOWNER: Carolyn Young

Pl 2 Box 63

Wrighton Miss  
(mailing address)

description of formations encountered

from

to

Sandy Clay	0	15
Sand	15	38
Hard Clay	38	43

WELL LOCATION:

sec. 9 T. 5 N R. 10 E  
S W  
5 1/2 miles NW of Wrighton  
(distance) (direction) (nearest town)

WELL PURPOSE: Home  
(home, irrigation, municipal, industrial)

WELL COMPLETION DATA:

- (1) diameter (inches) 2
- (2) total depth (feet) 38
- (3) static water level (feet) 32 below top of ground.
- (4) casing Galv. Iron 33, (material) (depth)
- (size) If telescope see back.
- (5) screen 5, 33 (length) (depth to top)
- 1/4 Solid S.S. 006 (size) (material)
- (6) pump 1/2 4 (HP) (yield gpm)
- Electric (type power)
- (7) electric log NO (yes or no)

(organization running log)

(8) how well bottom plugged B.W.V.

DRILLERS REMARKS: Used Customers


old pump, set 8 A jet @ 30 ft 6 in

RECEIVED  
NOV - 8 1976

MISS. Bd. OF WATER COMMISSIONERS

If well telescopes please sketch and show depths.

GROUND LEVEL

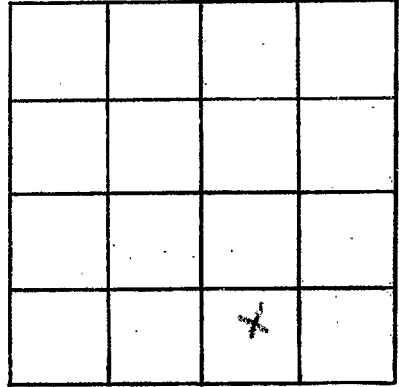

SECTION 9

Please indicate well location X.

ADDITIONAL INFORMATION

If more than one screen,  
show locations of each on sketch.