

MISSISSIPPI DEPARTMENT OF ENVIRONMENTAL QUALITY

Office of Land and Water Resources

P. O. Box 10631

Jackson, MS 39289-0631

WATER WELL DRILLERS LOG

COUNTY WELL LOCATED
PERRY CO.

WELL NUMBER CODED
B-2026

DATE WELL COMPLETED
5-3-02

PERMIT NUMBER

NAME OF DRILLING FIRM
FARKER

WELL SERVICE

NAME & MAILING ADDRESS OF LANDOWNER
WINOR JOHNSON
OVET MS.

Latitude:
Longitude:

WELL LOCATION. SEC TOWNSHIP RANGE
17 5 N 10 E

DISTANCE DIRECTION NEAREST TOWN
10 Miles **N.E.** of **RUMBLE**

OTHER LANDMARK
COUNTY LINE CHURCH

WELL PURPOSE: Home, Irrigation, Municipal, Industrial, Fish Pond, etc.
Home

WELL DATA

Well Depth Casing Diameter (In.) Casing Length (Ft.)
295' **2"** **285'**

Type of Casing Hole Depth Depth to Static Water Level
PVC **300'** **Flowing**

TYPE OF COMPLETION: (Circle One or More):
 Gravel Packed, Underreamed, Telescoped,
 Natural Development, Open Hole, Other
(Describe)

WELL GROUTED TO A DEPTH OF **10 FEET**
Type Grout (circle one): Cement, Bentonite, or Mix

SCREEN DATA

Diameter - Inches Length - Feet Slot Size - Inches
2" **10'** **008**

Screen Type Depth to Bottom - Feet
PVC **295'**

PUMP DATA

PUMP TYPE (Circle One):
Submersible, Turbine, Jet, Flowing Well,
Other (Describe)

POWER TYPE (Circle One):
 Electric, Tractor, Diesel, Gasoline, Butane,
Other (Describe) H/P **2**

DESCRIPTION OF FORMATIONS ENCOUNTERED	FROM	TO
SAND	0	20
CLAY SAND	20	280
GRAVEL SAND	280	300

RECEIVED
MAY 16 2002
BY: OLWR

Top of Lap Pipe or Reduction in Casing

FEET IF TELESCOPED OR MORE THAN ONE SCREEN: USE BACK PAGE

I certify that the well was drilled, constructed and completed in accordance with all applicable Requirements of the Mississippi Department of Environmental Quality and/or the Mississippi Department of Health regulations and state laws.


John R. Parker
Signature of Licensed Driller and License No.

5-7-02
Date

Additional Information Required On Back

If well telescopes please sketch and show depths.

GROUND LEVEL

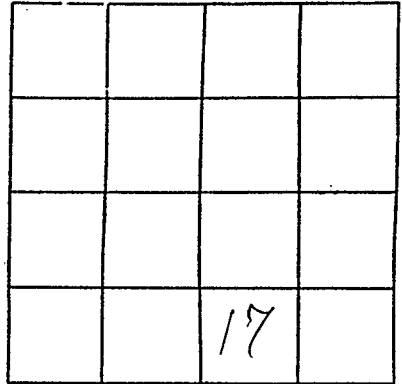

SECTION 12

Please indicate well location X.

Pump Capacity (GPM)	No. of Stages	Setting Depth	FT.
PUMP TEST			
Well yielded <u>8</u> GPM with			
a drawdown of _____ ft.			
after <u>10</u> hours of pumping			

LOG DATA

TYPE OF LOG RUN (Circle One): No Log Run, Electric, Gamma Ray, Density, Sonic, Neutron, Other (Describe) _____

Name of Organization Running Log _____

GEOLOGIC DATA (Office Use Only)

Surface Elev.	Geologic Unit	Unit Thickness	Depth to Top
Subs. SWL	Date	Analysis	Aquifer Test

Driller's Remarks

well Flowing
GOT WATER ON
TWO INCH PIPE
TO SHUTOFF FLOW

If more than one screen, show location of each on sketch.