


If well telescopes please sketch and show depths.

GROUND LEVEL

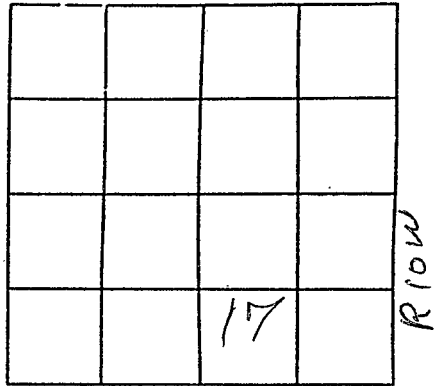

SECTION 17

Please indicate well location X.

Pump Capacity (GPM) <u>10</u>	No. of Stages <u>1</u>	Setting Depth <u>40</u> FT.
----------------------------------	---------------------------	--------------------------------

PUMP TEST

Well yielded _____ GPM with
a drawdown of _____ ft.
after _____ hours of pumping

LOG DATA

TYPE OF LOG RUN (Circle One): No Log Run, Electric, Gamma Ray, Density, Sonic, Neutron, Other (Describe) _____

Name of Organization Running Log _____

GEOLOGIC DATA (Office Use Only)

Surface Elev.	Geologic Unit	Unit Thickness	Depth to Top
Subs. SWL	Date	Analysis	Aquifer Test

Driller's Remarks

HAVE NOT RUN ELEC
WELL FLOWING & LOG
11 IN HAVE WELL SET
ON WITH PUMP AND
3/4" VALVE

If more than one screen,
show location of each on sketch.