

PERRY

C 13

7-20-60

WATER WELL DRILLERS LOG

23

300

Date: July 20, 1960, Driller: DAVID NEWELL & SON County PERRY  
 (Name)

(1) Owner of Land: JOHN C. & CLAIR L. GUTHRIE  
 (Name)  
RICHTON, MISS.  
 (Address)

(2) Location: SW 1/4, SW 1/4, Sec 33 T5 R9  
4 miles EAST of RICHTON  
 (distance) (direction) (Nearest Town)

(3) Topography: HILLY  
 (Hilly) (Flat) (Level)

(4) Purpose of Well: DOMESTIC (to stock  
 (Domestic Irrigation (10,000 chick.)  
 Municipal, Industrial, Other)

Description & Color of Materials (Sand, Clay, Red Clay, Shell, etc.)	Thick- ness Feet	Depth Feet
<u>RED CLAY</u>		<u>0 30</u>
<u>COARSE SAND</u>		<u>30 34</u>
<u>WHITE CLAY</u>		<u>34 296</u>
<u>STREAKS OF SAND &amp; CLAY</u>		<u>296 295</u>
<u>WHITE CLAY</u>		<u>295 400</u>
<u>SAND &amp; GRAVEL</u>		<u>400 428</u>

Information upon completion of well:

(1) Diameter 4 1/4 inches.

(2) Total Depth 428 feet.


(3) Water Level 40 feet below top of ground.

(4) Cased to 418, Size 2 in

(5) Screen: Size 2 in, Length 10 ft.

(6) Were any formations sealed against pollution?  
✓ yes, \_\_\_\_\_ no.

If YES depth of formation WHITE CLAY  
 Why \_\_\_\_\_  
 Drillers Remarks: 1 HP Jet

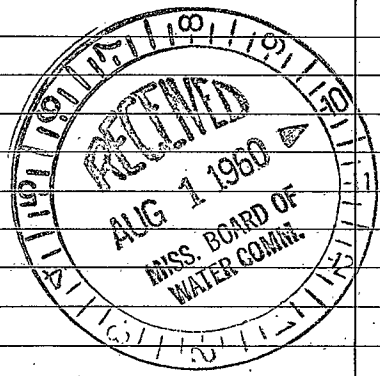

Red H<sub>2</sub>O, stain

(Use Back Side)

Well No.

7