

MISSISSIPPI BOARD OF WATER COMMISSIONERS

WATER WELL DRILLERS LOG

Perry
C18
10-66

Perry

Date: 10-7, 1966, Driller: A & R Drillers County: Perry

104 Thompson Blvd.

(Name) Petal Miss.

(1) Owner of Land: Tommy Edwards Jr.
(Name)

Description & Color of Materials
Sand, Clay, Red Clay, Shell, etc.

Thick-
ness
Feet

Depth
Feet

R.F.D. 1 - Box 18 Richon Miss.
(Address)

Red clay

10 10

(2) Location: NW 1/4, SW 1/4, Sec. 21 5N7W

Blue "

10 20

6 7/8 miles NE, of Richon Miss.
(distance) (direction) (Nearest Town)

Gray "

10 20

Blue "

20 50

Fine sand

20 70

Good sand

15 85

(3) Topography: Hilly
(Hilly) (Flat) (Level)

(4) Purpose of Well: Home
(Domestic Irrigation
Municipal, Industrial, Other)

Information upon completion of well:

(1) Diameter 2 inches.

(2) Total Depth 85 feet.

(3) Water Level 10 feet below top of ground.

(4) Cased to 80, Size 2"

(5) Screen: Size 2", Length 5'


(6) Were any formations sealed against pollution?

no.

If YES depth of formation _____

Why _____

Drillers Remarks: _____

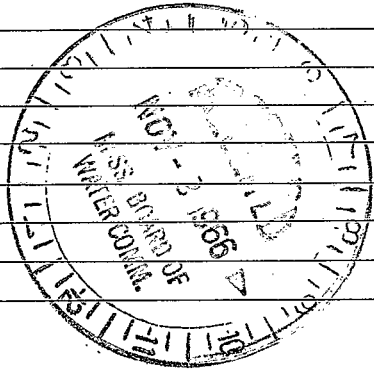

(Use Back Side)

Well No.

