

Perry
C19
11-66

MISSISSIPPI BOARD OF WATER COMMISSIONERS

WATER WELL DRILLERS LOG

Date: 11-15, 1966, Driller: J & R Drilling Co. County: DeWitt
104 Thompson Metal Mine

(1) Owner of Land: Cecil Vannell
(Name)
Rt. 7, D. 1, Bickton mine
(Address)
(2) Location: NW 1/4, SW 1/4, Sec. 21 T19R9W
3 1/2 miles N. E. of Bickton
(distance) (direction) (Nearest Town)
(3) Topography: Hilly
(Hilly) (Flat) (Level)
(4) Purpose of Well: Home
(Domestic Irrigation
Municipal, Industrial, Other)


Description & Color of Materials Sand, Clay, Red Clay, Shell, etc.	Thick- ness Feet	Depth Feet
<u>Red clay</u>	<u>10</u>	<u>10</u>
<u>White clay</u>	<u>20</u>	<u>30</u>
<u>Sand Rock & gravel</u>	<u>10</u>	<u>40</u>
<u>Gray clay</u>	<u>10</u>	<u>50</u>
<u>Blue c'</u>	<u>20</u>	<u>70</u>
<u>Gray il</u>	<u>60</u>	<u>130</u>
<u>Brown c'</u>	<u>40</u>	<u>170</u>
<u>Blue clay</u>	<u>30</u>	<u>200</u>
<u>Blue shell</u>	<u>60</u>	<u>260</u>
<u>Fine sand</u>	<u>10</u>	<u>270</u>
<u>Gray clay</u>	<u>30</u>	<u>300</u>
<u>Sand sand</u>	<u>20</u>	<u>320</u>

Information upon completion of well:

(1) Diameter 2 inches.
(2) Total Depth 320 feet.
(3) Water Level 10 feet below top of ground.
(4) Cased to 310, Size 2 in
(5) Screen: Size 2 in, Length 10 ft
(6) Were any formations sealed against pollution?

yes, no.

If YES depth of formation _____
Why _____
Drillers Remarks: _____

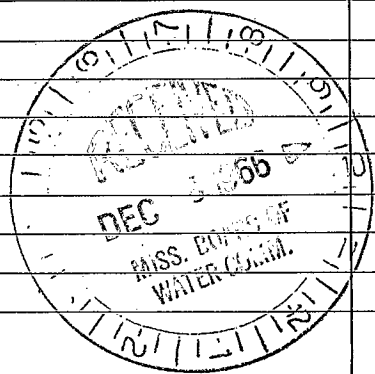

(Use Back Side)

Well No.

