

PERRY
C20
8-64

MISSISSIPPI BOARD OF WATER COMMISSIONERS

WATER WELL DRILLERS LOG

CODED

Date: Aug, 1964, Driller: Peeples Drilling Co County Perry
176/21 (Name)

(1) Owner of Land: Roland Watson
(Name)
Box 51 Richton
(Address)

(2) Location: 1/4, 1/4, Sec. 32-59
1 miles E, of Richton
(distance) (direction) (Nearest Town)

(3) Topography: Level to Hill
(Hilly) (Flat) (Level)

(4) Purpose of Well: Home
(Domestic Irrigation
Municipal, Industrial, Other)

Description & Color of Materials Sand, Clay, Red Clay, Shell, etc.	Thick- ness Feet	Depth Feet
<u>Red Sandy clay</u>	<u>6</u>	<u>6</u>
<u>White clay</u>	<u>15</u>	<u>21</u>
<u>Brown clay</u>	<u>21</u>	<u>42</u>
<u>White clay</u>	<u>73</u>	<u>115</u>
<u>White Sandy clay</u>	<u>42</u>	<u>157</u>
<u>Gray Sandy shale</u>	<u>157</u>	<u>315</u>
<u>Gray sand + shale</u>	<u>21</u>	<u>336</u>
<u>Fine Gray sand</u>	<u>9</u>	<u>345</u>
<u>Red Gravel</u>	<u>39</u>	<u>384</u>

Information upon completion of well:

(1) Diameter: ~~2 1/2~~ 2 inches.

(2) Total Depth 384 feet.

(3) Water Level 8 feet below top of ground.

(4) Cased to 378', Size 2"

(5) Screen: Size 2", Length 6'


(6) Were any formations sealed against pollution?
_____ yes, _____ no.

If YES depth of formation _____

Why _____

Drillers Remarks: _____

CODED

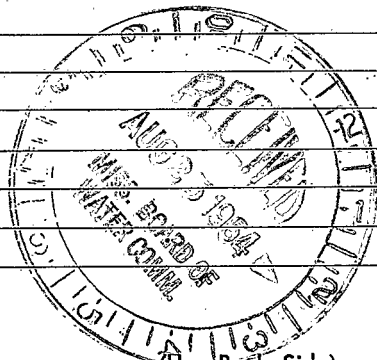

Well No.

MEMORANDUM

TO : SAC, NEW YORK

FROM : SAC, NEW YORK

SUBJECT: [Illegible]

[Illegible]

[Illegible]

