

PERRY
C25
7-64

WATER WELL DRILLERS LOG

CODED

Date: July, 1964, Driller: Peeples Drilling Co County Perry
162/18 169/1, 19 (Name)

(1) Owner of Land: Edgar Walls
(Name)

(Address)

(2) Location: 1/4, 1/4, Sec. 28 T 5 R 9
4 miles E of Richton
(distance) (direction) (Nearest Town)

(3) Topography: Hills
(Hilly) (Flat) (Level)

(4) Purpose of Well: Home
(Domestic Irrigation
Municipal, Industrial, Other)

Description & Color of Materials Sand, Clay, Red Clay, Shell, etc.	Thick- ness Feet	Depth Feet
<u>Yellow to white clay</u>	<u>31</u>	<u>31</u>
<u>Yellow clay + sand shale</u>	<u>17</u>	<u>42</u>
<u>White sandy clay</u>	<u>73</u>	<u>115</u>
<u>Blue sand clay</u>	<u>21</u>	<u>136</u>
<u>Blue sand shale</u>	<u>158</u>	<u>294</u>
<u>Five Gray sand</u>	<u>6</u>	<u>300</u>
<u>Gray sand shale</u>	<u>28</u>	<u>328</u>
<u>7 in white sand</u>	<u>8</u>	<u>336</u>
<u>Gray sand shale</u>		
<u>+ small sand streak</u>	<u>43</u>	<u>379</u>
<u>White sand</u>	<u>31</u>	<u>410</u>


Information upon completion of well:

(1) Diameter 2 inches.
(2) Total Depth 410 feet.
(3) Water Level 1 feet below top of ground.
(4) Cased to 404', Size 2"
(5) Screen: Size 2", Length 6'
(6) Were any formations sealed against pollution?
_____ yes, _____ no.

If YES depth of formation _____
Why _____

Drillers Remarks: _____

CODED

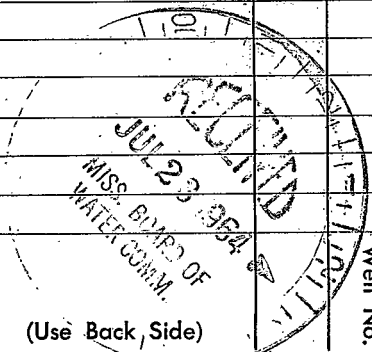

(Use Back Side)

Well No.

1000

1000