

PERRY

MISSISSIPPI BOARD OF WATER COMMISSIONERS

C30

4-12-61

WATER WELL DRILLERS LOG

CODED

Date: 4-12, 1961, Driller: David Newell County: Perry

199/33

(Name)

(1) Owner of Land: Bill Stevenson

(Name)

Rt 2 Richton Miss

(Address)

(2) Location: With held 1959

2 miles north, of Richton

(distance) (direction) (Nearest Town)

(3) Topography: Hilly

(Hilly) (Flat) (Level)

(4) Purpose of Well: Domestic

(Domestic Irrigation
Municipal, Industrial, Other)

Description & Color of Materials
Sand, Clay, Red Clay, Shell, etc.

Thick-
ness
Feet

Depth
Feet

Red Clay
Sand & Gravel

60

30

Information upon completion of well:

(1) Diameter: 2 inches.

(2) Total Depth: 90 feet.

(3) Water Level: 60 feet below top of ground.

(4) Cased to 2", Size 2"

(5) Screen: Size 2", Length 8'

(6) Were any formations sealed against pollution?


yes, X no.

If YES depth of formation _____

Why _____

Drillers Remarks: _____

CODED

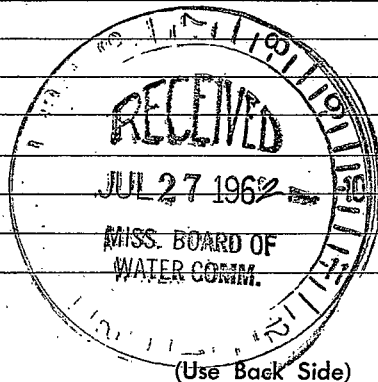

Well No.

