

PERRY

MISSISSIPPI BOARD OF WATER-COMMISSIONERS

OC 32

6-11-61

WATER-WELL DRILLERS LOG ~~not located~~ **CODED** *81102*

Date: 6-11, 19 61, Driller: David Newell County Perry  
(Name) 130/28

(1) Owner of Land: Marilyn Dyles  
(Name)  
Rt 2 Richton Miss.  
(Address)

(2) Location: with hole 9.5<sup>N</sup> 9<sup>W</sup>  
(direction)  
8 miles north of Richton  
(distance) (direction) (Nearest Town)

(3) Topography: Hilly  
(Hilly) (Flat) (Level)

(4) Purpose of Well: Domestic  
(Domestic Irrigation  
Municipal, Industrial, Other)

Description & Color of Materials Sand, Clay, Red Clay, Shell, etc.	Thick- ness Feet	Depth Feet
<u>Red Clay</u>		<u>30</u>
<u>Chalky Clay</u>		<u>290</u>
<u>Sand</u>		<u>40</u>

Information upon completion of well:

(1) Diameter 2 inches.

(2) Total Depth 360 feet.

(3) Water Level 170 feet below top of ground.

(4) Cased to 2", Size 2"


(5) Screen: Size 2", Length 10'

(6) Were any formations sealed against pollution?  
\_\_\_\_\_ yes, X no.

If YES depth of formation \_\_\_\_\_  
Why \_\_\_\_\_

Drillers Remarks: \_\_\_\_\_  
\_\_\_\_\_  
\_\_\_\_\_

**CODED**

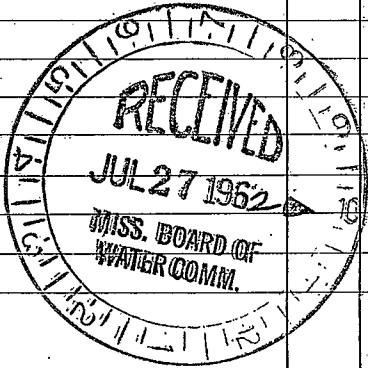

(Use Back Side)

Well No.

100

1000

1000

