

PERRY  
C34

**CODED**

**WATER WELL DRILLERS LOG**

5-12-62

Date: 5-12, 1962, Driller: David Newell County Perry  
12515 (Name)

	Description & Color of Materials Sand, Clay, Red Clay, Shell, etc.	Thick- ness Feet	Depth Feet
(1) Owner of Land: <u>Thomas Walley</u> (Name) <u>Route 2, Pickett, Miss</u> (Address)	<u>Chalk Clay</u> <u>Sand</u>		<u>251</u> <u>39</u>
(2) Location: <u>W 1/4, Sec. 5 5 9</u> <u>6 miles North</u> of <u>Pickett</u> (distance) (direction) (Nearest Town)			
(3) Topography: <u>Hilly</u> (Hilly) (Flat) (Level)			
(4) Purpose of Well: <u>Domestic</u> (Domestic Irrigation Municipal, Industrial, Other)			

**CODED**


Information upon completion of well:

- (1) Diameter 2 inches.
- (2) Total Depth 290 feet.
- (3) Water Level Flow feet below top of ground.
- (4) Cased to 2", Size 2"
- (5) Screen: Size 2", Length 5'
- (6) Were any formations sealed against pollution?  
\_\_\_\_\_ yes, X no.

If YES depth of formation \_\_\_\_\_

Why \_\_\_\_\_

Drillers Remarks: \_\_\_\_\_

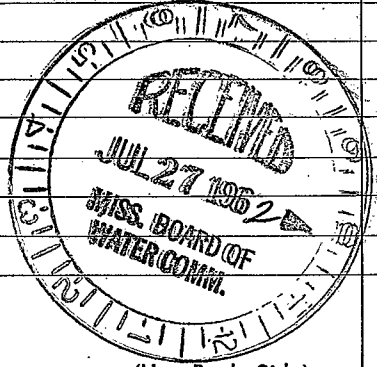

(Use Back Side)

Well No.

1900

...

...

