

PERRY
C 35
7-64

MISSISSIPPI BOARD OF WATER COMMISSIONERS

WATER WELL DRILLERS LOG

CODED

Date: July, 1964, Driller: Peeples Drilling Co County Perry
15811 (Name)

(1) Owner of Land: Darrell Harrison
(Name)
Rt 4 Richton, Miss
(Address)

(2) Location: 1/4, 1/4, Sec. 26 5 9
_____ miles _____ of _____
(distance) (direction) (Nearest Town)

(3) Topography: Hilly
(Hilly) (Flat) (Level)

(4) Purpose of Well: Home
(Domestic Irrigation
Municipal, Industrial, Other)

Description & Color of Materials Sand, Clay, Red Clay, Shell, etc.	Thick- ness Feet	Depth Feet
<u>Yellow sandy clay</u>	<u>28</u>	<u>28</u>
<u>White clay</u>	<u>24</u>	<u>52</u>
<u>Blue shale & small sand streaks</u>	<u>298</u>	<u>350</u>
<u>Gray sand</u>	<u>40</u>	<u>390</u>

Information upon completion of well:

(1) Diameter: 2 inches.

(2) Total Depth: 390 feet.

(3) Water Level: 31 feet below top of ground.

(4) Cased to: 384", Size 2"

(5) Screen: Size 2", Length 6'


(6) Were any formations sealed against pollution?
_____ yes, _____ no.

If YES depth of formation _____

Why _____

Drillers Remarks: _____

CODED

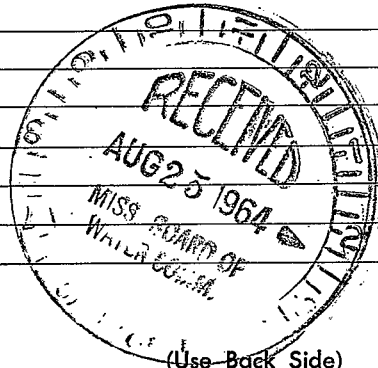

(Use Back Side)

Well No.

