

JONES

PERRY C 43

WATER WELL DRILLERS LOG

7-26-60

Date: July 26, 1960, Driller: DAVID NEWELL, County: PERRY

Handwritten notes and signatures in the top right corner.

(1) Owner of Land: FORREST, DYKES (Name)

RD #2 RICHTON, MISS. (Address)

(2) Location: NE 1/4, SE 1/4, Sec. 10 T5R9

7 miles N W, of RICHTON (distance) (direction) (Nearest Town)

(3) Topography: Hilly (Hilly) (Flat) (Level)

(4) Purpose of Well: DOMESTIC (Domestic Irrigation, Municipal, Industrial, Other)

Description & Color of Materials Sand, Clay, Red Clay, Shell, etc.

Thickness Feet

Depth Feet

CLAY 0 35
SAND 35 38
CLAY 38 218
STREKS, OF SAND 218 267

Information upon completion of well:

(1) Diameter 4 1/2 inches.

(2) Total Depth 167 feet.

(3) Water Level 60 feet below top of ground.

(4) Cased to 200 ft, Size 2 in.

(5) Screen: Size V, Length V


(6) Were any formations sealed against pollution?

V yes, no.

If YES depth of formation 35 ft

Why its hard clay

Drillers Remarks:

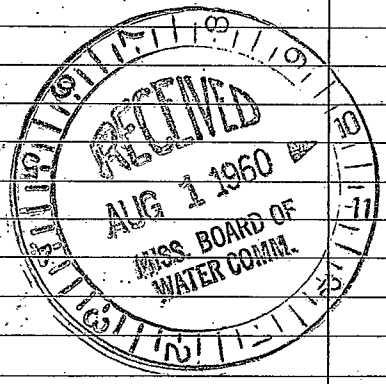

0895750
312420N

(Use Back Side)

Well No. 5

