

Perry  
 C 44  
 7-68

MISSISSIPPI  
 BOARD OF WATER COMMISSIONERS  
 416 North State Street  
 Jackson, Mississippi 39201

CODED

WATER WELL DRILLERS LOG

July 10 19 68 Time Drill Co. Perry  
 date well completed firm name county well located

LANDOWNER:

Mr. J. Waller  
 Richter Road 1  
 (mailing address)

description of formations encountered

from to

Clay	0	8
Clay Gravel	8	16
Sand	16	40
Clay	40	48
Sand	48	68

WELL LOCATION:


sec. 30 T 5 S R 9 E  
 2 1/2 miles N of Richter  
 (distance) (direction) (nearest town)

WELL PURPOSE:

Home  
 (home, irrigation, municipal, industrial)

WELL COMPLETION DATA:


- (1) diameter (inches) 2
- (2) total depth (feet) 65
- (3) static water level (feet) 20 <sup>below</sup> <sub>above</sub> top of ground.
- (4) casing PVC (material), 60 (depth)  
 \_\_\_\_\_ if telescope see back.  
 (size)
- (5) screen 5 (length), 60 (depth to top)  
2 (size), plastic (material)
- (6) pump 1 (HP), 9 (yield gpm)  
Ch. (type power)
- (7) electric log No (yes or no)  
 \_\_\_\_\_ (organization running log)
- (8) how well bottom plugged Waller

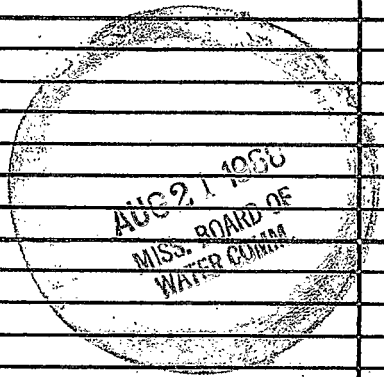

DRILLERS REMARKS:

If well telescopes please sketch and show depths.

GROUND LEVEL

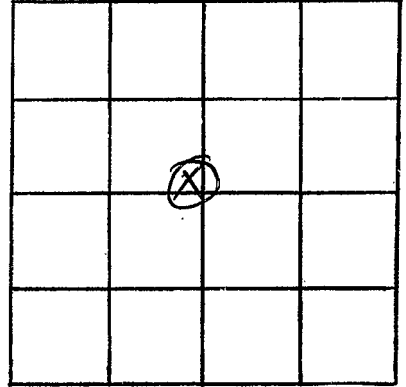

SECTION 30

Please indicate well location X.

ADDITIONAL INFORMATION

If more than one screen,  
show locations of each on sketch.