

Perry
C48
11-3-69

MISSISSIPPI BOARD OF WATER COMMISSIONERS
416 North State Street
Jackson, Mississippi 39201
C. B. CLARK
WELL DRILLING
PAGE 2
LAUREL, MISS. 39440

WATER WELL DRILLERS LOG

11/3 1969
date well completed

C. B. Clark
firm name

Perry
county well located

LANDOWNER: C. B. Clark

Richton Miss.

(mailing address)

WELL LOCATION:

sec 30 T 50 N R 9 E S 1 W
1/4 miles NW of Richton
(distance) (direction) (nearest town)

WELL PURPOSE: Home
(home, irrigation, municipal, industrial)

WELL COMPLETION DATA:

- (1) diameter (inches) 2
- (2) total depth (feet) 68
- (3) static water level (feet) 60 below above top of ground.
- (4) casing Galv. Iron (material), (depth)
- (size) if telescope see back.
- (5) screen 5 ft, 6.3 (length) (depth to top)
1 1/4, Solid S.S., #10 (size) (material)
- (6) pump 1 (HP), 10 (yield gpm)
110V S.P. (type power)
- (7) electric log NO (yes or no)
- (organization running log)
- (8) how well bottom plugged BVV


description of formations encountered	from	to
Med. Sandy Clay	0	12
Shale Clay	12	17
Coarse Sand	17	30
Coarse Sand & Gravel	30	68

DRILLERS REMARKS:

JAN - 5 1970
MISS. SD. OF
WELL DRILLERS COM.

If well telescopes please sketch and show depths.

GROUND LEVEL

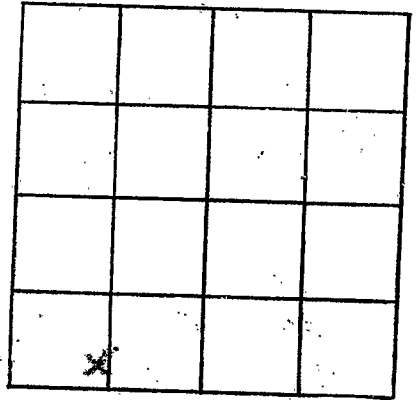

SECTION 30

Please indicate well location X.

ADDITIONAL INFORMATION

If more than one screen,
show locations of each on sketch.