

PERRY
C52
11-1-70

MISSISSIPPI
BOARD OF WATER COMMISSIONERS
416 North State Street
Jackson, Mississippi 39201
WATER WELL DRILLERS LOG

CODED

11-1 1970 S&P Perry
date well completed firm name county well located

LANDOWNER: Mr. Hollister
Richton, Miss.
(mailing address)

description of formations encountered	from	to
Gravelly Clay	0	6
Red Clay	6	14
Free white sand	14	61
White Boring Sand	61	78

WELL LOCATION:
sec. 18 T 5 N R 9 E S
3 miles N of Richton
(distance) (direction) (nearest town)

WELL PURPOSE: Home
(home, irrigation, municipal, industrial)

- WELL COMPLETION DATA:
- (1) diameter (inches) 2"
 - (2) total depth (feet) 75 ft
 - (3) static water level (feet) 4.8 below top of ground
 - (4) casing plastic (material), 70 (depth)
2" (size) if telescope see back.
 - (5) screen 5' (length), 70 (depth to top)
2" (size), plastic (material)
 - (6) pump _____ (HP) _____ (yield gpm)
_____ (type power)
 - (7) electric log _____ (yes or no)
_____ (organization running log)
 - (8) how well bottom plugged Value

CODED


NOV 19 1970

MISS. BD OF
WATER COMMISSIONERS

DRILLERS REMARKS:

If well telescopes please sketch and show depths.

GROUND LEVEL

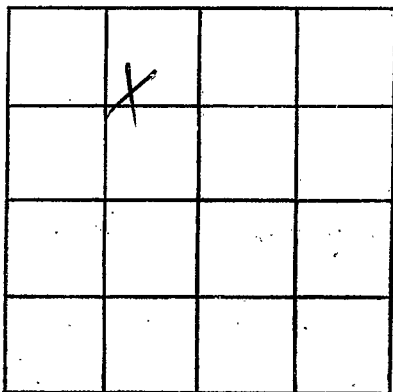

SECTION 18

Please indicate well location X.

ADDITIONAL INFORMATION

If more than one screen,
show locations of each on sketch.