

MISSISSIPPI
BOARD OF WATER COMMISSIONERS
416 North State Street
Jackson, Mississippi 39201

CODED

WATER WELL DRILLERS LOG

PERRY
C53
11-10-70

11-10-70 date well completed S+R firm name Perry county well located

LANDOWNER: Wayn Young
Pickett, Miss.

description of formations encountered	from	to
<u>Clay sand</u>	<u>0</u>	<u>9</u>
<u>gravel</u>	<u>9</u>	<u>12</u>
<u>Clay string</u>	<u>12</u>	<u>13</u>
<u>fine sand</u>	<u>13</u>	<u>50</u>

(mailing address)

WELL LOCATION:

sec 30 T 5 N R 9 E
S W
1/2 miles N of Pickett
(distance) (direction) (nearest town)

WELL PURPOSE: Home
(home, irrigation, municipal, industrial)

WELL COMPLETION DATA:

- (1) diameter (inches) 2"
- (2) total depth (feet) 12
- (3) static water level (feet) 24 below above top of ground.
- (4) casing PVC, 37,
(material) (depth)
2" if telescope see back.
(size)
- (5) screen 5, 37
(length) (depth to top)
2", PVC
(size) (material)
- (6) pump _____, _____
(HP) (yield gpm)
(type power)
- (7) electric log _____
(yes or no)
(organization running log)
- (8) how well bottom plugged Valve

CODED


NOV 13 1970

DRILLERS REMARKS:

MISS. BD. OF
WATER COM.

If well telescopes please sketch and show depths.

GROUND LEVEL

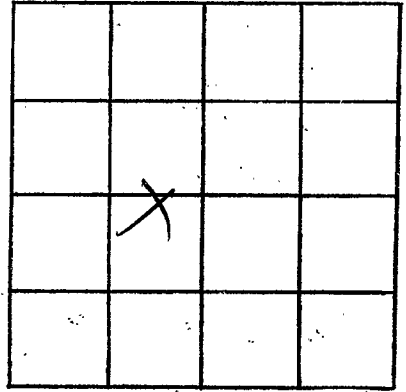

SECTION 30

Please indicate well location X.

ADDITIONAL INFORMATION

If more than one screen,
show locations of each on sketch.