

PERRY
C55
11-30-71

MISSISSIPPI
 BOARD OF WATER COMMISSIONERS
 416 North State Street
 Jackson, Mississippi 39201

CODED 071

WATER WELL DRILLERS LOG

MISS. Bd. of
 WATER COMMISSIONERS

Nov 30 19 71 Cochran Drilling firm name Perry county well located

LANDOWNER: Jagan Richter
Rt 3 Richton
 (mailing address)

description of formations encountered	from	to
TOP soil	0	5
red clay	5	10
gray clay	10	18
hardy clay	18	28
sand	28	45

WELL LOCATION:
 sec. 30 T. 50 S. R. 9 E.
3 miles N of Richton
 (distance) (direction) (nearest town)

WELL PURPOSE: None
 (home, irrigation, municipal, industrial)


- WELL COMPLETION DATA:
- (1) diameter (inches) 2
 - (2) total depth (feet) 45
 - (3) static water level (feet) 9 ^{below} top of ground _{above}
 - (4) casing PVC 40
 (material) (depth)
 (size) If telescope see back.
 - (5) screen 5' 40
 (length) (depth to top)
2 PVC
 (size) (material)
 - (6) pump 3/4 6
 (HP) (yield gpm)
Elic
 (type power)
 - (7) electric log no
 (yes or no)
 (organization running log)
 - (8) how well bottom plugged Value

CODED

DRILLERS REMARKS:

If well telescopes please sketch and show depths.

GROUND LEVEL

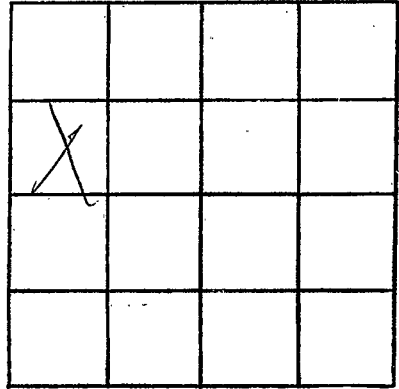

SECTION 30

Please indicate well location X.

ADDITIONAL INFORMATION

If more than one screen,
show locations of each on sketch.