

PERRY
C. 57
9-27-73

MISSISSIPPI
 BOARD OF WATER COMMISSIONERS
 416 North State Street
 Jackson, Mississippi 39201 **CODED**

WATER WELL DRILLERS LOG

9-27 1973 J. D. Howell Drilling, Inc. Perry Co.
 date well completed firm name county well located

LANDOWNER: J. D. Howell
RFD 2
Richman miss.
 (mailing address)

WELL LOCATION:
 sec. 3 T. 5 N. R. 9 E.
5 miles NE of Richman
 (distance) (direction) (nearest town)

WELL PURPOSE: Home
 (home, irrigation, municipal, industrial)

- WELL COMPLETION DATA:
- (1) diameter (inches) 2"
 - (2) total depth (feet) 362 ft
 - (3) static water level (feet) 42 below above top of ground.
 - (4) casing Plastic 352 ft
 (material) (depth)
2" if telescope see back.
 (size)
 - (5) screen 10 ft 362 ft
 (length) (depth to top)
2", Plastic
 (size) (material)
 - (6) pump 1 950 GPH
 (HP) (yield gpm)
Gas
 (type power)
 - (7) electric log
 (yes or no)
✓
 (organization running log)
 - (8) how well bottom plugged plugged


description of formations encountered	from	to
<u>sandy clay</u>	<u>0</u>	<u>12</u>
<u>breccia &c</u>	<u>12</u>	<u>21</u>
<u>Clay</u>	<u>21</u>	<u>76</u>
<u>Fine sand</u>	<u>76</u>	<u>79</u>
<u>Clay</u>	<u>79</u>	<u>125</u>
<u>breccia &c</u>	<u>125</u>	<u>130</u>
<u>Shell</u>	<u>130</u>	<u>145</u>
<u>Clay CODED</u>	<u>145</u>	<u>175</u>
<u>breccia &c</u>	<u>175</u>	<u>180</u>
<u>Clay</u>	<u>180</u>	<u>210</u>
<u>Fine sand</u>	<u>210</u>	<u>255</u>
<u>Clay</u>	<u>255</u>	<u>290</u>
<u>Fine sand</u>	<u>290</u>	<u>320</u>
<u>Hard sand</u>	<u>320</u>	<u>350</u>
<u>Old gravel & sand</u>	<u>350</u>	<u>362</u>

DRILLERS REMARKS:

OCT 9 1973

If well telescopes please sketch and show depths.

GROUND LEVEL

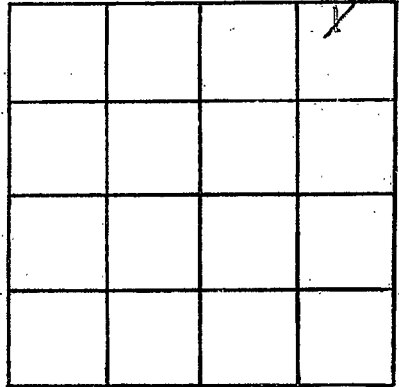

SECTION _____

Please indicate well location X.

ADDITIONAL INFORMATION

If more than one screen, show locations of each on sketch.