

Perry
C 58
8-13-74

MISSISSIPPI WATER WELL DRILLING
BOARD OF WATER COMMISSIONERS
416 North State Street
Jackson, Mississippi 39201
C. P. CLARK
CODEB
LAUREL, MISS. 39440

WATER WELL DRILLERS LOG

8/13 1974 date well completed
C. P. Clark firm name
Perry county well located

LANDOWNER: Billy Mc Carlin

description of formations encountered

from to

R.O. Box 223
Piketon Miss
(mailing address)

White Clay	0	102
Clay w soft streaks	102	147
Clay & Sand	147	152
Hard Clay	152	218
Sandy streaks	218	232
Clay	232	239
fine sand	239	246
Mixed Clay Sand	246	256
Clay	256	266
fine sand	266	271
Soft sandy clay	271	297
Clay	297	305
sandy streaks	305	315
Clay	315	334
fine sand	334	339
Clay	339	345
Hard fine sand	345	386
Hard clay	386	387
sand pipe	387	407
Clay	407	421

WELL LOCATION:

sec 27 T 56 N R 9 E
2 1/2 miles NE of Piketon
(distance) (direction) (nearest town)

WELL PURPOSE: Home
(home, irrigation, municipal, industrial)

WELL COMPLETION DATA:

- (1) diameter (inches) 2
- (2) total depth (feet) 407
- (3) static water level (feet) 25 below top of ground.
- (4) casing Galvanized 389
(material) (depth)
- (size) if telescope see back.
- (5) screen 18 389
(length) (depth to top)
- 1 1/4 55 80 gauge
(size) (material)
- (6) pump 3/4 12
(HP) (yield gpm)
- 2200 500
(type power)
- (7) electric log No
(yes or no)
- (organization running log)
- (8) how well bottom plugged BWU


DRILLERS REMARKS: Set 12 1/4
9 1/2 @ 84 ft 7 ft w.
3 stage jet pump 1 1/4
drop pipe

RECEIVED
SEP 9 1974

MISS. RD. OF WATER COMMISSIONERS

If well telescopes please sketch and show depths.

GROUND LEVEL

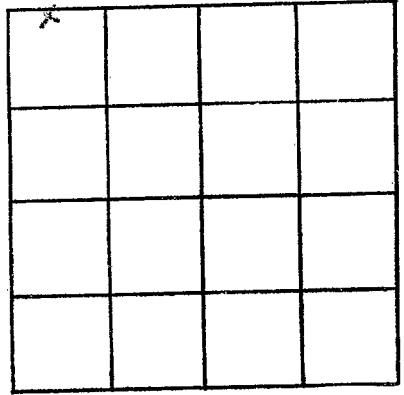

SECTION _____

Please indicate well location X.

ADDITIONAL INFORMATION

If more than one screen, show locations of each on sketch.