

Perry
C59
7-31-74

MISSISSIPPI
BOARD OF WATER COMMISSIONERS
416 North State Street
Jackson, Mississippi 39201

CODED

WATER WELL DRILLERS LOG

7-31-1974 date well completed
Sumrell Drilling Co Perry firm name
county well located


LANDOWNER: <u>W.D. Bennett</u>	description of formations encountered	from	to
<u>Box 151</u> <u>Richton miss</u> (mailing address)			
WELL LOCATION: sec. <u>3</u> T. <u>5</u> N. R. <u>9</u> E. S. W. <u>1/4</u> miles <u>S</u> <u>Richton</u> (distance) (direction) (nearest town)	<u>clay</u>	<u>0</u>	<u>8</u>
WELL PURPOSE: <u>farm</u> (home, irrigation, municipal, industrial)	<u>sand</u>	<u>8</u>	<u>22</u>
WELL COMPLETION DATA: (1) diameter (inches) <u>2 1/8</u>	<u>fine gray sand</u>	<u>22</u>	<u>52</u>
(2) total depth (feet) <u>65 ft</u>	<u>hard sand</u>	<u>52</u>	<u>65</u>
(3) static water level (feet) <u>10 ft</u> below/above top of ground.			
(4) casing <u>plastic</u> <u>60 ft</u> (material) (depth)			
<u>2"</u> (size) If telescope see back.			
(5) screen <u>5 ft</u> <u>65 ft</u> (length) (depth to top)			
<u>2"</u> <u>plastic</u> (size) (material)			
(6) pump <u>1</u> <u>900 gpm</u> (HP) (yield gpm)			
<u>900</u> (type power)			
(7) electric log <input checked="" type="checkbox"/> (yes or no)			
<u>✓</u> (organization running log)			
(8) how well bottom plugged <u>none</u>			
DRILLERS REMARKS:			

RECEIVED
SEP 11 1974

MISS. BD. OF WATER COMMISSIONERS

If well telescopes please sketch and show depths.

GROUND LEVEL

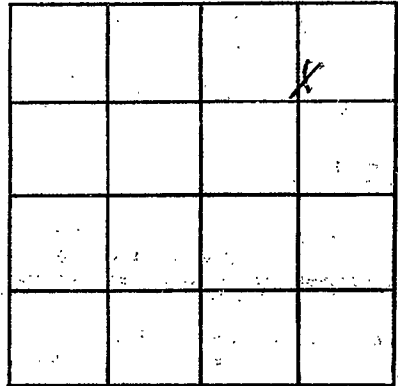

SECTION _____

Please indicate well location X.

ADDITIONAL INFORMATION

If more than one screen, show locations of each on sketch.