

MISSISSIPPI DEPARTMENT OF NATURAL RESOURCES

Bureau of Land and Water Resources

Southport Mall

P.O. Box 10631

Jackson, Mississippi 39209

WATER WELL DRILLERS LOG

CODED

PERRY  
C 62

May 31 1984 date well completed  
 24 Porter Drilling & Sump firm name  
 Perry county well located

LANDOWNER: Charles Malone  
 P.O. Box 411  
 Richton, Miss.  
 (mailing address)

WELL LOCATION:  
 sec. 32 T. 5 N R. 9 E  
 S W  
 1 miles E of Richton  
 (distance) (direction) (nearest town)

WELL PURPOSE: Home  
 (home, irrigation, municipal, industrial)

WELL COMPLETION DATA:

- (1) diameter (inches) 2'
- (2) total depth (feet) 34.5'
- (3) static water level (feet) 12' below top of ground.
- (4) casing PVC, 340' (material) (depth)  
 2" (size) if telescope see back.
- (5) screen 5' 6 slot S.S. (length) (depth to top)  
 2" (size) 6 slot S.S. (material)
- (6) pump 1 (HP) 15 (yield gpm)  
 elec. (type power)
- (7) electric log no (yes or no)
- (organization running log)
- (8) how well bottom plugged  
 2' sand blank

description of formations encountered	from	to
red clay	0	15
fine sand	15	25
clay	25	200
clay bone sand	200	225
clay	225	262
clay bone sand	262	270
clay	270	307
clay & fine sand	307	325
sand & fine sand	325	327
fine sand	327	335
med. fine sand	335	345
shell in sand		

32' 1" P.V.C. drop gauge

CODED

DEPT. OF NATURAL RESOURCES  
 BUREAU OF LAND & WATER RESOURCES


AUG 6 1984

RECEIVED

DRILLERS REMARKS:

If well telescopes please sketch and show depths.

GROUND LEVEL

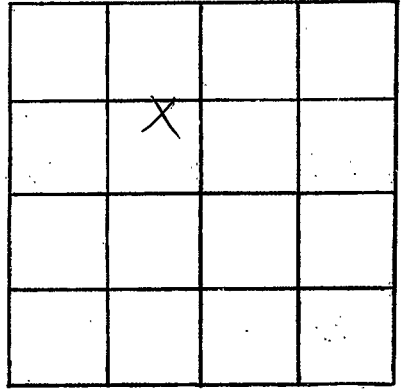

SECTION 32

Please indicate well location X.

ADDITIONAL INFORMATION

If more than one screen,  
show locations of each on sketch.