

MISSISSIPPI DEPARTMENT OF NATURAL RESOURCES

Bureau of Land and Water Resources

Southport Mall

P.O. Box 10631

Jackson, Mississippi 39209

WATER WELL DRILLERS LOG

CODED

C63
 PERRY
 10-31-84

Oct 31-1984 date well completed
 Cochran Water Well Service firm name
 Perry county well located

LANDOWNER:	description of formations encountered	from	to
Cleve Newell			
Rt 2 Richton (mailing address)	Red clay	1	2
	gray clay	7	53
	blue clay	53	97
	sand	97	101
	blue clay sand	101	288
	sand	288	320
WELL LOCATION: sec. 21 T 50 N R 9 E S 4 miles NE of Richton (distance) (direction) (nearest town)			
WELL PURPOSE: (Home Irrigation, municipal, industrial)			
WELL COMPLETION DATA:			
(1) diameter (inches) 2"			
(2) total depth (feet) 320'			
(3) static water level (feet) 2 below top of ground.			
(4) casing PVC 310' (material) (depth) 2" (size) If telescope see back.			
(5) screen 10' 310' (length) (depth to top) 2" (size) PVC (material)			
(6) pump 1 (HP) 9 (yield gpm) 9 hp (type power)			
(7) electric log (yes or no) (organization running log)			
(8) how well bottom plugged Value			
DRILLERS REMARKS:			


DEPT. OF NATURAL RESOURCES
 BUREAU OF LAND & WATER RESOURCES

DEC 10 1984

RECEIVED

If well telescopes please sketch and show depths.

GROUND LEVEL

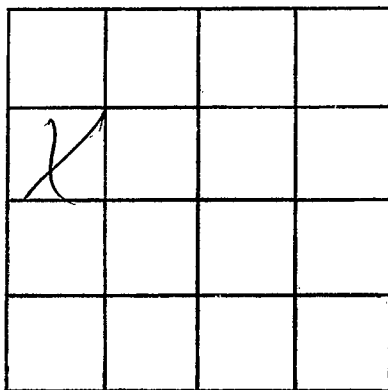

SECTION 26

Please indicate well location X.

ADDITIONAL INFORMATION

If more than one screen,
show locations of each on sketch.