

MISSISSIPPI DEPARTMENT OF NATURAL RESOURCES

Bureau of Land and Water Resources

Southport Mall

P.O. Box 10631

Jackson, Mississippi 39209

CODED

WATER WELL DRILLERS LOG

C65  
PERRY  
4-11-85

4-11-85 Griner Drilling Service, INC.

Perry

date well completed

firm name

county well located

LANDOWNER:

Kelly Brothers Contractors  
P.O. Box 335  
Waynesboro, MS. 39637  
(mailing address)

description of formations encountered

from

to

CLAY	0	357
SAND, pea gravel	357	420

WELL LOCATION: 3600'S & 1550'E

TEXACO, INC.  
sec. 13-T-50 R-9-E of  
Nop. Sand Hill-Richon  
Di. (miles) (direction) (nearest town)  
Gooding

WELL PURPOSE: Oilfield supply  
(home, irrigation, municipal, industrial)

WELL COMPLETION DATA:

- (1) diameter (inches) 4"
- (2) total depth (feet) 420'
- (3) static water level (feet) 50' below top of ground.
- (4) casing steel, 420' (material) (depth)  
4" (size) if telescope see back.
- (5) screen 42' 378' (length) (depth to top)  
4" perforated (size) (material)
- (6) pump - 90 (HP) (yield gpm)  
AC (type power)
- (7) electric log (yes or no)

(organization running log)

- (8) how well bottom plugged orange peel

DRILLERS REMARKS:

CODED


RECEIVED  
APR 18 1985

Department of Natural Resources  
Bureau of Land & Water Resources

If well telescopes please sketch and show depths.

GROUND LEVEL

24.1  
24.2  
24.3  
24.4  
24.5  
24.6  
24.7  
24.8  
24.9  
25.0

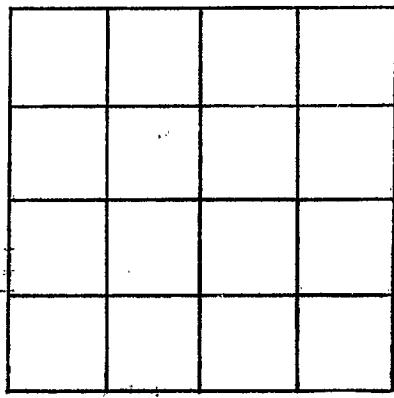

SECTION \_\_\_\_\_

Please indicate well location X.

ADDITIONAL INFORMATION

If more than one screen, show locations of each on sketch.