

MISSISSIPPI DEPARTMENT OF NATURAL RESOURCES

Bureau of Land and Water Resources

Southport Mall

P.O. Box 10631

Jackson, Mississippi 39209

WATER WELL DRILLERS LOG

Perry  
C 2000  
4-3-81

APR 13

1981 Corbett Brothers Drilling Service


Perry

date well completed

firm name

county well located


LANDOWNER:	description of formations encountered	from	to
W. C. Edwards Rt 3 Richton (mailing address)			
	Red Clay	1	6
	Red clay sand	6	15
	GRAY clay	15	21
	sand + gravel	21	58
<p>WELL LOCATION:</p> <p>sec. 19 T 2 N R 9 E S 5 W</p> <p>4 miles N of Richton (distance) (direction) (nearest town)</p> <p>WELL PURPOSE: Home (home, irrigation, municipal, industrial)</p> <p>WELL COMPLETION DATA:</p> <p>(1) diameter (inches) 2 1/2</p> <p>(2) total depth (feet) 58'</p> <p>(3) static water level (feet) 3' below top of ground.</p> <p>(4) casing PVC 53' (material) (depth)</p> <p>(size) if telescope see back.</p> <p>(5) screen 5' 53' (length) (depth to top)</p> <p>2" PVC (size) (material)</p> <p>(6) pump _____ (HP) (yield gpm)</p> <p>(type power)</p> <p>(7) electric log _____ (yes or no)</p> <p>(organization running log)</p> <p>(8) how well bottom plugged VALVE</p>			

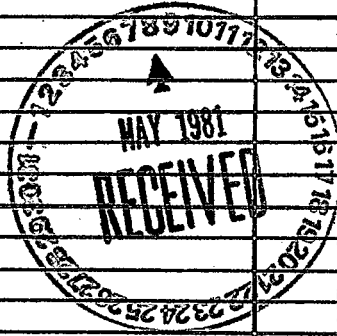

DRILLERS REMARKS:

If well telescopes please sketch and show depths.

GROUND LEVEL

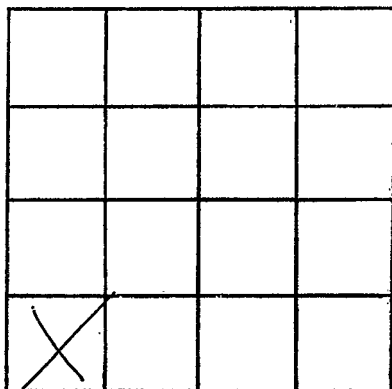

SECTION 19

Please indicate well location X.

ADDITIONAL INFORMATION

If more than one screen,  
show locations of each on sketch.