

**MISSISSIPPI
BOARD OF WATER COMMISSIONERS**
416 North State Street
Jackson, Mississippi 39201

WATER WELL DRILLERS LOG

Perry
DT
6-68

6/11 19*68* *SRK Drilling* *Perry*
date well completed firm name county well located

LANDOWNER: *Essie L. Perry*
pt 2 box 68
Hattiesburg Miss.
(mailing address)

WELL LOCATION:
sec *30* T *4* N *✓* R *11* E
S W
8 miles *SE* of *Patit*
(distance) (direction) (nearest town)

WELL PURPOSE: *Home*
(home, irrigation, municipal, industrial)

- WELL COMPLETION DATA:
- (1) diameter (inches) *2"*
 - (2) total depth (feet) *110*
 - (3) static water level (feet) *57* below
top of ground.
 - (4) casing *plastic* *105'*
(material) (depth)
2" if telescope see back.
(size)
 - (5) screen *5 ft.* *105'*
(length) (depth to top)
2" *plastic*
(size) (material)
 - (6) pump *1* *1900 ft.*
(HP) (yield gpm)
jet
(type power)
 - (7) electric log _____
(yes or no)

(organization running log)
 - (8) how well bottom plugged *Valve*


description of formations encountered	from	to
<i>Clay</i>	<i>0</i>	<i>0</i>
<i>Smith Clay</i>	<i>10</i>	<i>20</i>
<i>Trind Sand</i>	<i>20</i>	<i>30</i>
<i>White Clay</i>	<i>30</i>	<i>50</i>
<i>Smith Clay</i>	<i>50</i>	<i>60</i>
<i>Trind Sand</i>	<i>60</i>	<i>80</i>
<i>Hard Sand</i>	<i>80</i>	<i>100</i>
<i>CWB Sand</i>	<i>100</i>	<i>110</i>

DRILLERS REMARKS:

JUL 2 1968
MISS. BOARD OF
WATER COMMISSIONERS

If well telescopes please sketch and show depths.

GROUND LEVEL

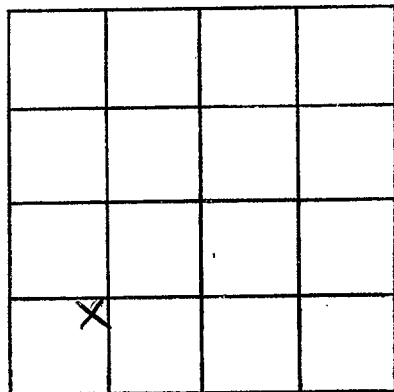

SECTION 30

Please indicate well location X.

ADDITIONAL INFORMATION

If more than one screen,
show locations of each on sketch.