

Perry
 D 9
 7-68

MISSISSIPPI
 BOARD OF WATER COMMISSIONERS
 416 North State Street
 Jackson, Mississippi 39201

CODED

WATER WELL DRILLERS LOG

7/9 1968 STR *Perry*
 date well completed firm name county well located

LANDOWNER: *M. Drayton*
RT 1
New Augusta, Miss
 (mailing address)

WELL LOCATION:
 sec *32 T 4 N R 11 E S W*
8 miles *S* of *Permeaton*
 (distance) (direction) (nearest town)

WELL PURPOSE: *Home*
 (home, irrigation, municipal, industrial)

WELL COMPLETION DATA:

(1) diameter (inches) *4"*

(2) total depth (feet) *85*

(3) static water level (feet) *31* below above top of ground.

(4) casing *plastic*, *80*
 (material), (depth)
4" if telescope see back.
 (size)

(5) screen *5 ft*, *80*
 (length) (depth to top)
4", *plastic*
 (size) (material)

(6) pump *1HP* *1800 No.*
 (HP) (yield gpm)
Sub
 (type power)

(7) electric log _____
 (yes or no)

 (organization running log)

(8) how well bottom plugged *Valve*

description of formations encountered	from	to
<i>Early Clay</i>	<i>0</i>	<i>18</i>
<i>Sand & gravel</i>	<i>18</i>	<i>47</i>
<i>Clay Shale</i>	<i>47</i>	<i>49</i>
<i>fine Sand</i>	<i>49</i>	<i>53</i>
<i>Clay Shale</i>	<i>53</i>	<i>59</i>
<i>fine Sand</i>	<i>59</i>	<i>63</i>
<i>Clay Shale</i>	<i>63</i>	<i>68 1/2</i>
<i>Sand</i>	<i>68 1/2</i>	<i>80</i>
<i>Clay Sand</i>	<i>80</i>	<i>85</i>


NOV 13 1968

DRILLERS REMARKS:

MISS. BD. OF
 WATER COMMISSIONERS

If well telescopes please sketch and show depths.

GROUND LEVEL

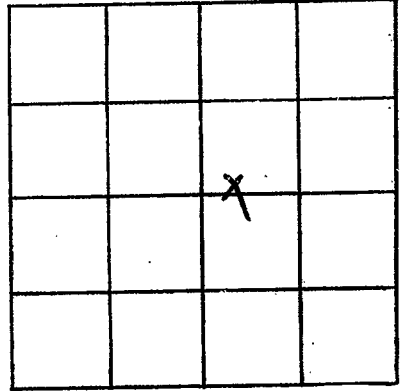

SECTION 32

Please indicate well location X.

ADDITIONAL INFORMATION

If more than one screen,
show locations of each on sketch.