

Perry
 D10
 8-23-68

MISSISSIPPI
 BOARD OF WATER COMMISSIONERS
 416 North State Street
 Jackson, Mississippi 39201

COPIED

WATER WELL DRILLERS LOG

8/23 1968 STR Perry
 date well completed firm name county well located

LANDOWNER: Robert Myers
 pt 2
 Hatheshay Myers
 (mailing address)

description of formations encountered	from	to
Clay Clay	0	10
Clay	10	20
fine sand	20	80
P.A. sand	80	110
P.W.B. sand	110	125


WELL LOCATION:
 sec 9 T 4 N R 11 E
 S W
 8 miles SE of H Perry
 (distance) (direction) (nearest town)

WELL PURPOSE: Home
 (home, irrigation, municipal, industrial)

- WELL COMPLETION DATA:
- (1) diameter (inches) 2"
 - (2) total depth (feet) 125
 - (3) static water level (feet) 70 below top of ground
 - (4) casing plastic 120 (material) (depth)
 2" (size) if telescope see back.
 - (5) screen 5 ft 120 (length) (depth to top)
 2" plastic (size) (material)
 - (6) pump 1 950 ft. (HP) (yield gpm)
1/2 (type power)
 - (7) electric log _____
 (yes or no)

 (organization running log)
 - (8) how well bottom plugged None


COPIED

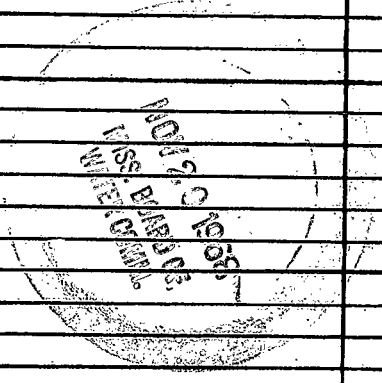

DRILLERS REMARKS:

If well telescopes please sketch and show depths.

GROUND LEVEL

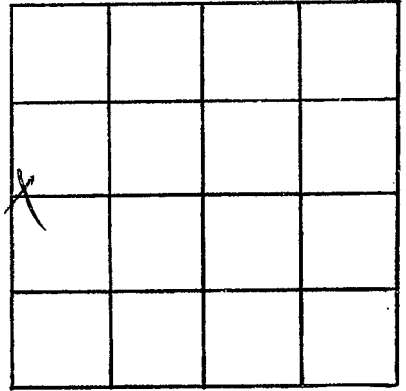

SECTION 19

Please indicate well location X.

ADDITIONAL INFORMATION

If more than one screen,
show locations of each on sketch.